

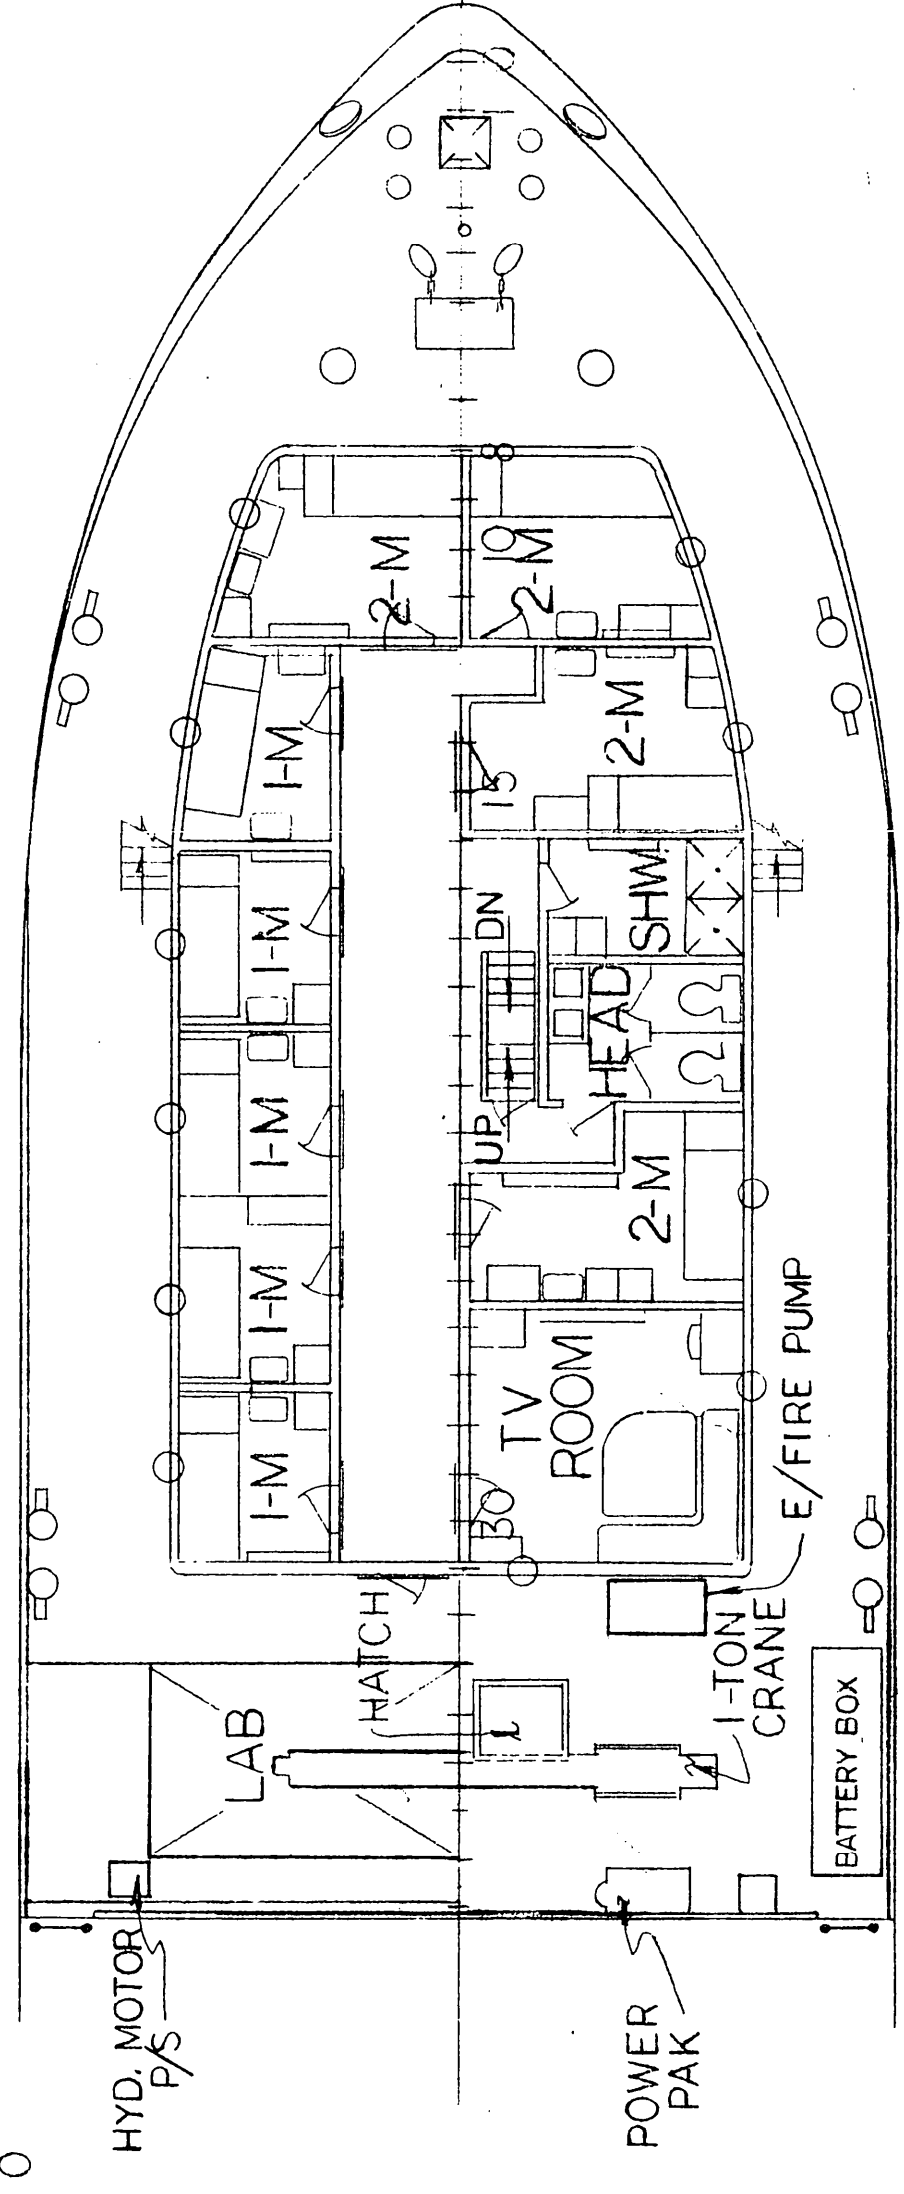
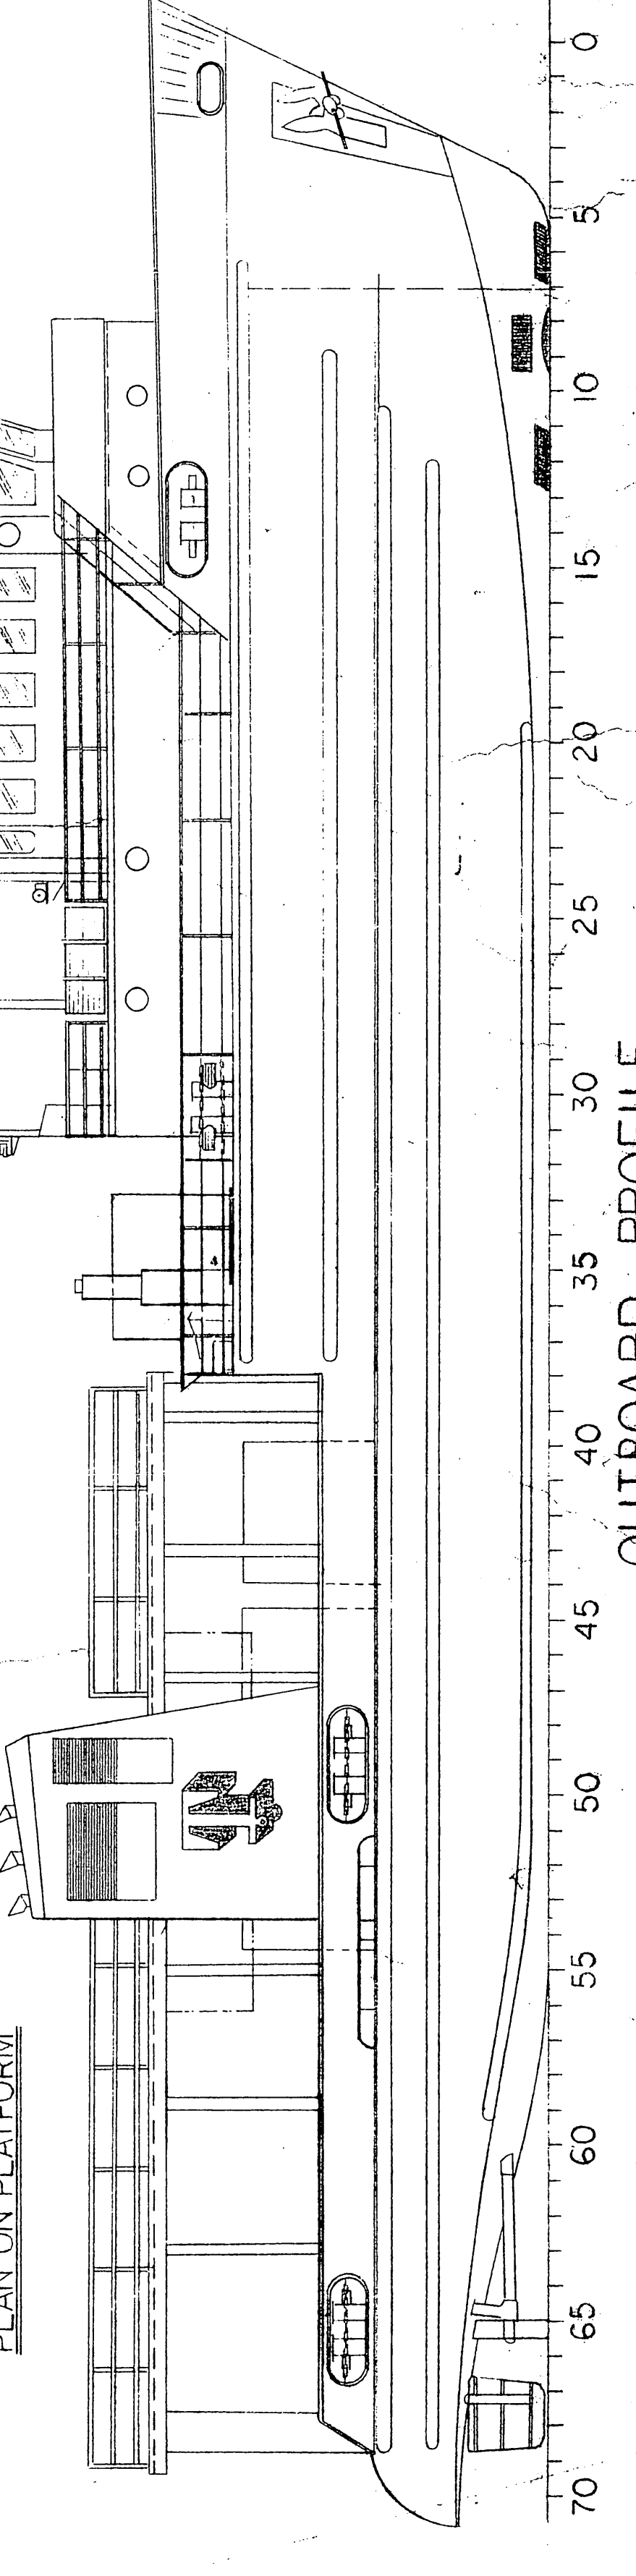
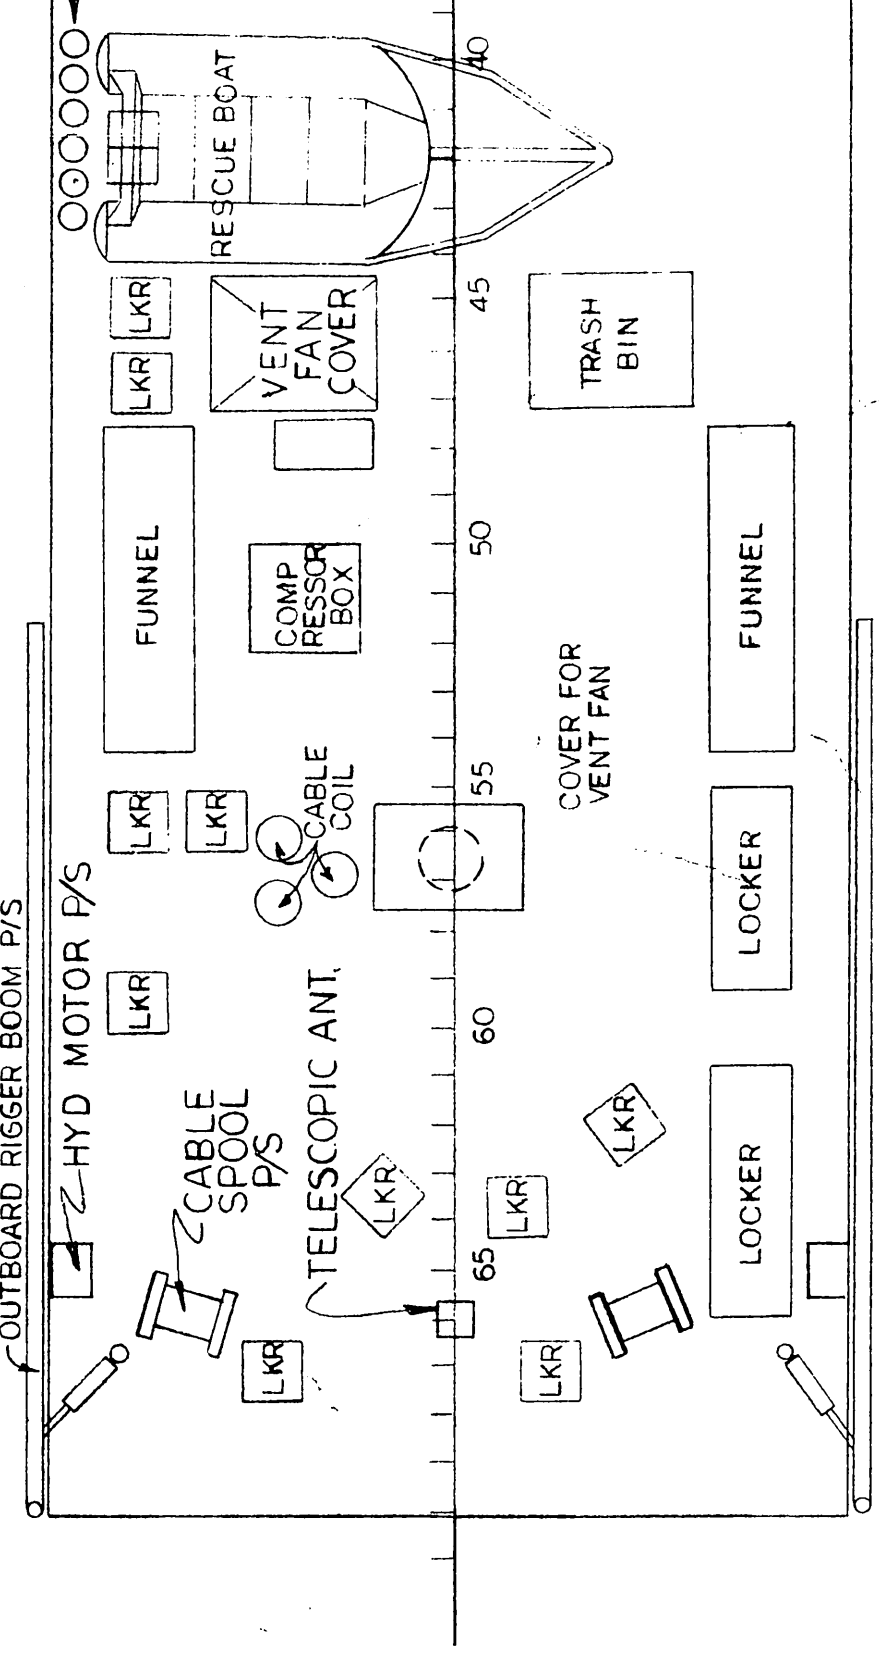
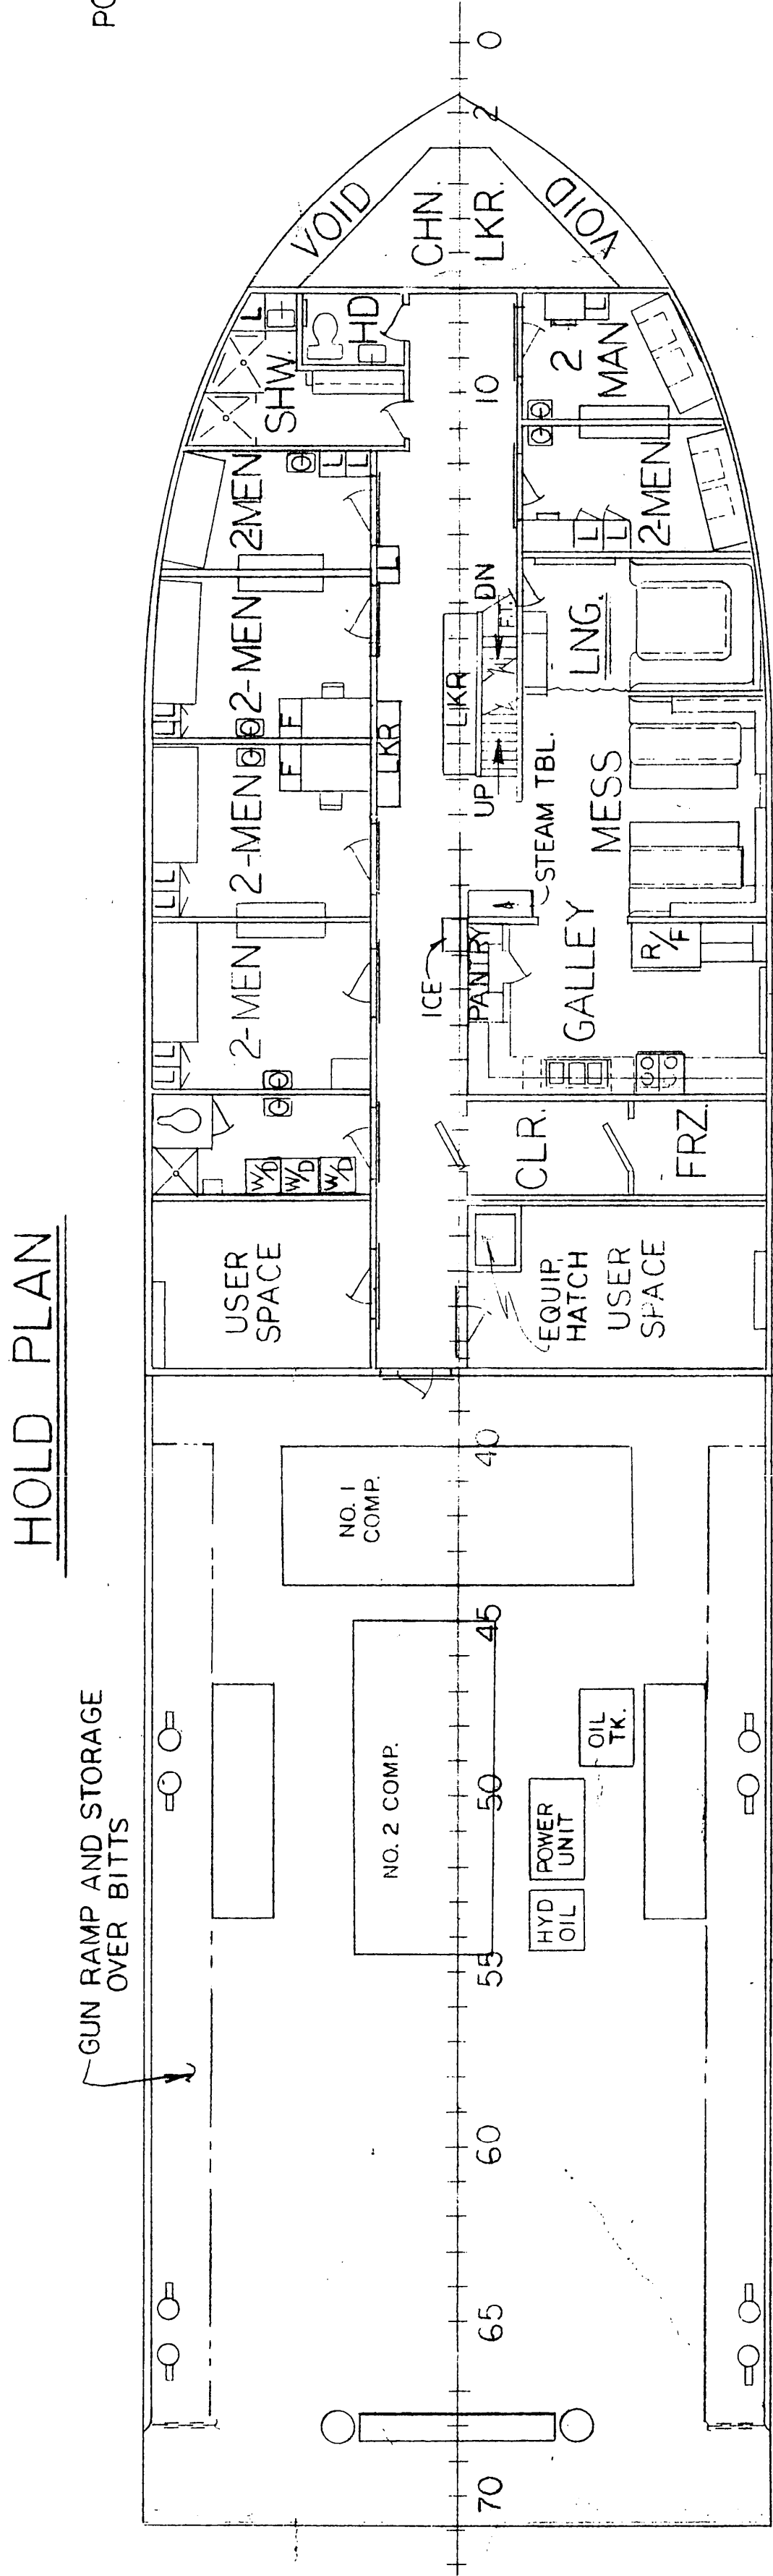


GENERAL NOTES:

1. THIS DWG. REPLACES TMS DWG'S 80-41-90-MM. AND 80-42-90-MM.

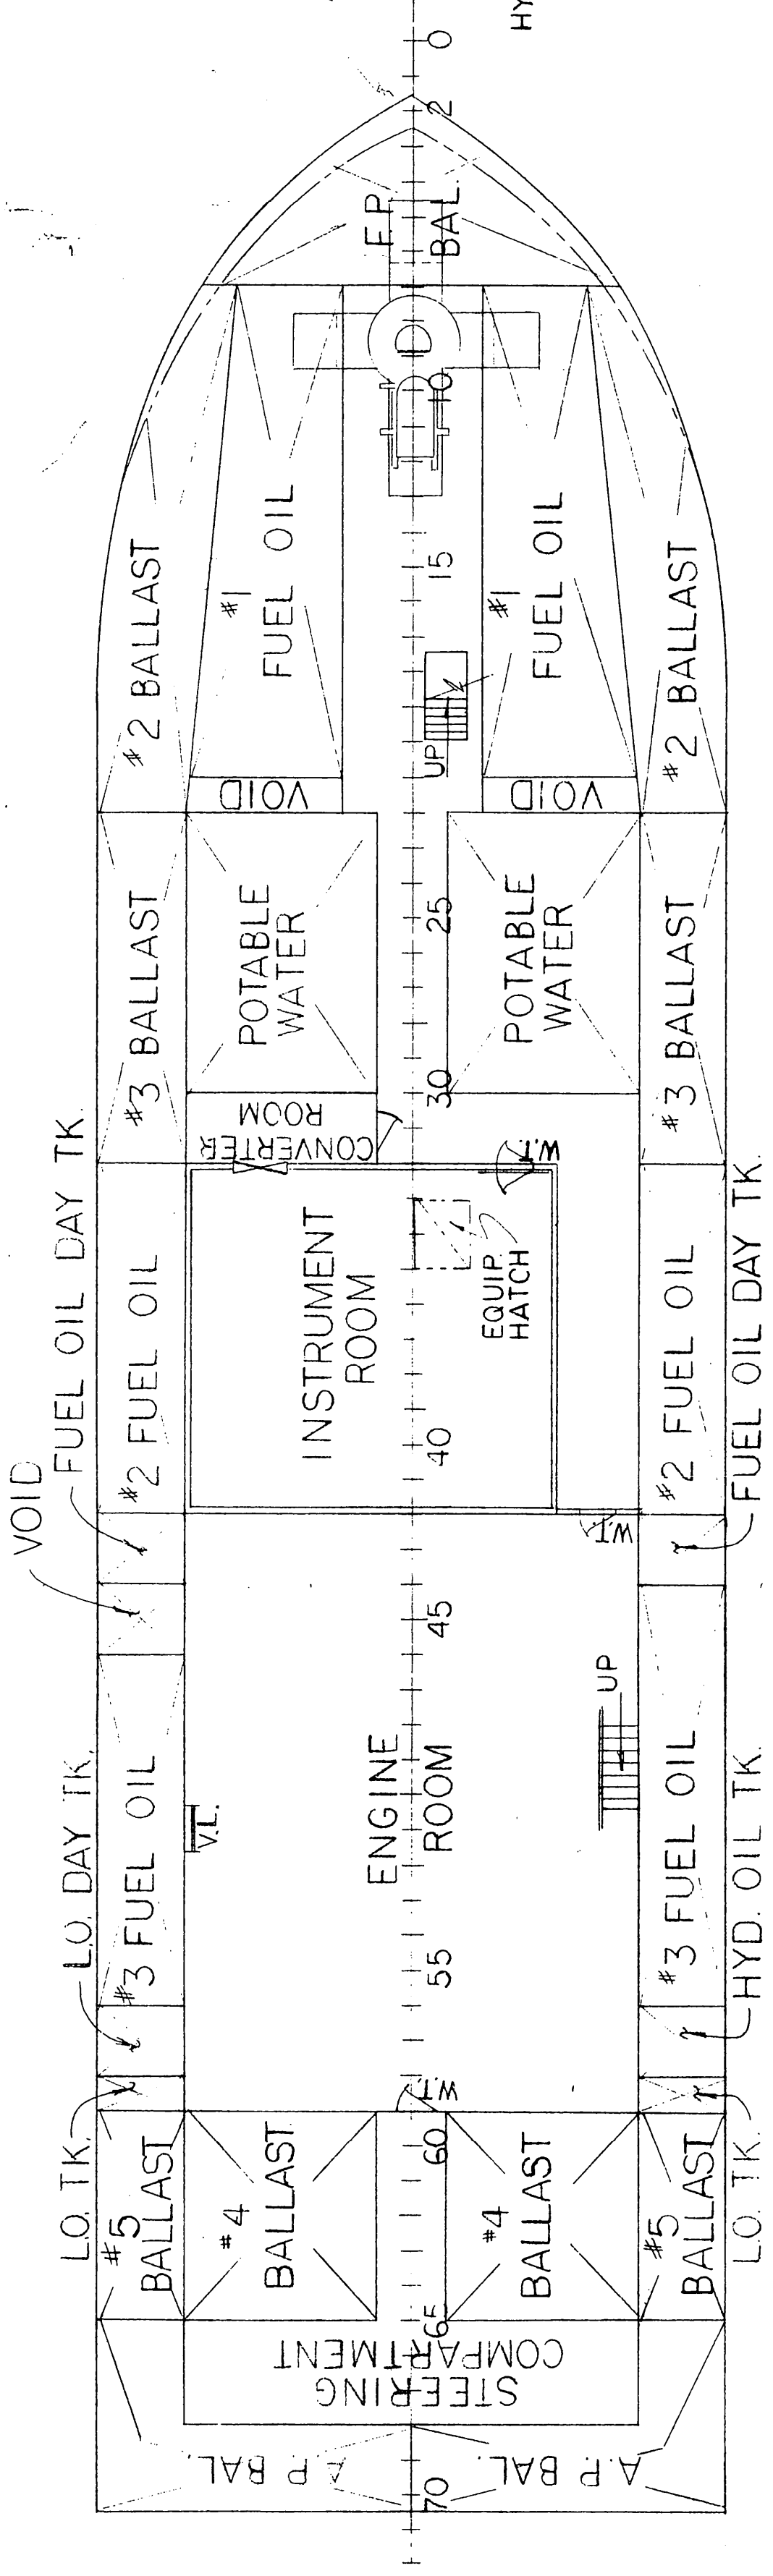

FOC'SLE DECK

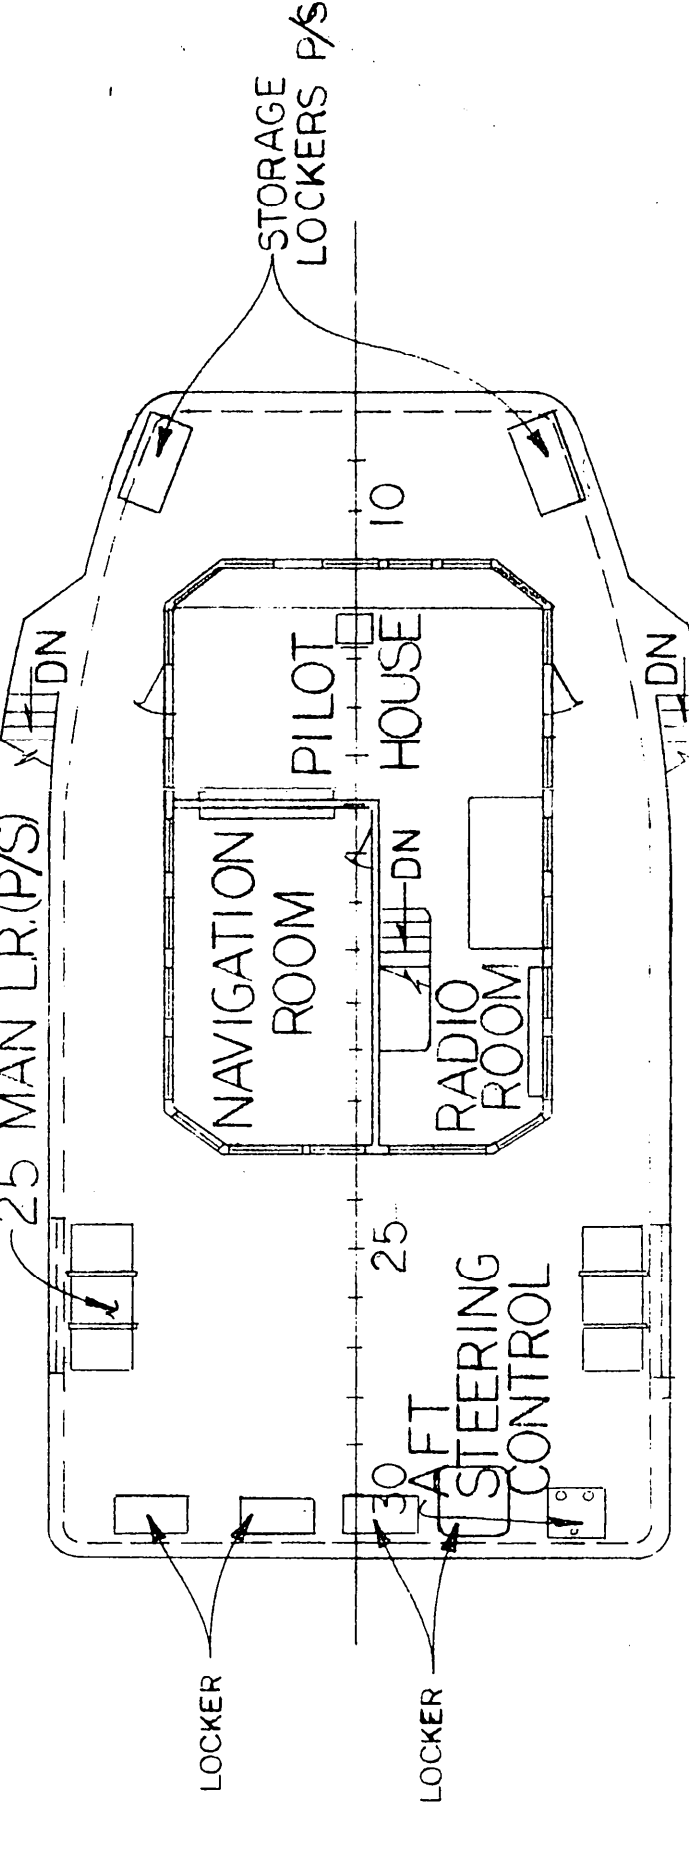

PILOT HOUSE

NO.	BY	DATE	ZONE	ALTERATION
2	ARL	1/7/94		REV'D. PER TASK NO. 10067
1	TDB	7/29/93		REVISED PER. AS-BUILT JOB NO. 3350

APPLICABLE SISTERSHIPS

NAME: _____ HULL NO. _____

143'-0" x 36'-0" x 10'-0" VSL

M/V GEO TIDE

GEN. ARRG'T. OIBD. PROF. & H.P.

TIDEWATER MARINE SERVICE

APPROD. DATE	INSTLD. DATE	HULL NO.
DATE	DATE	JOB NO.
3/4/81		
DRAWN BY	CHECKED BY	SCALE
A. FOLEY		1/8" = 1'-0"
DATE	DATE	REV.
3/4/81		1