 

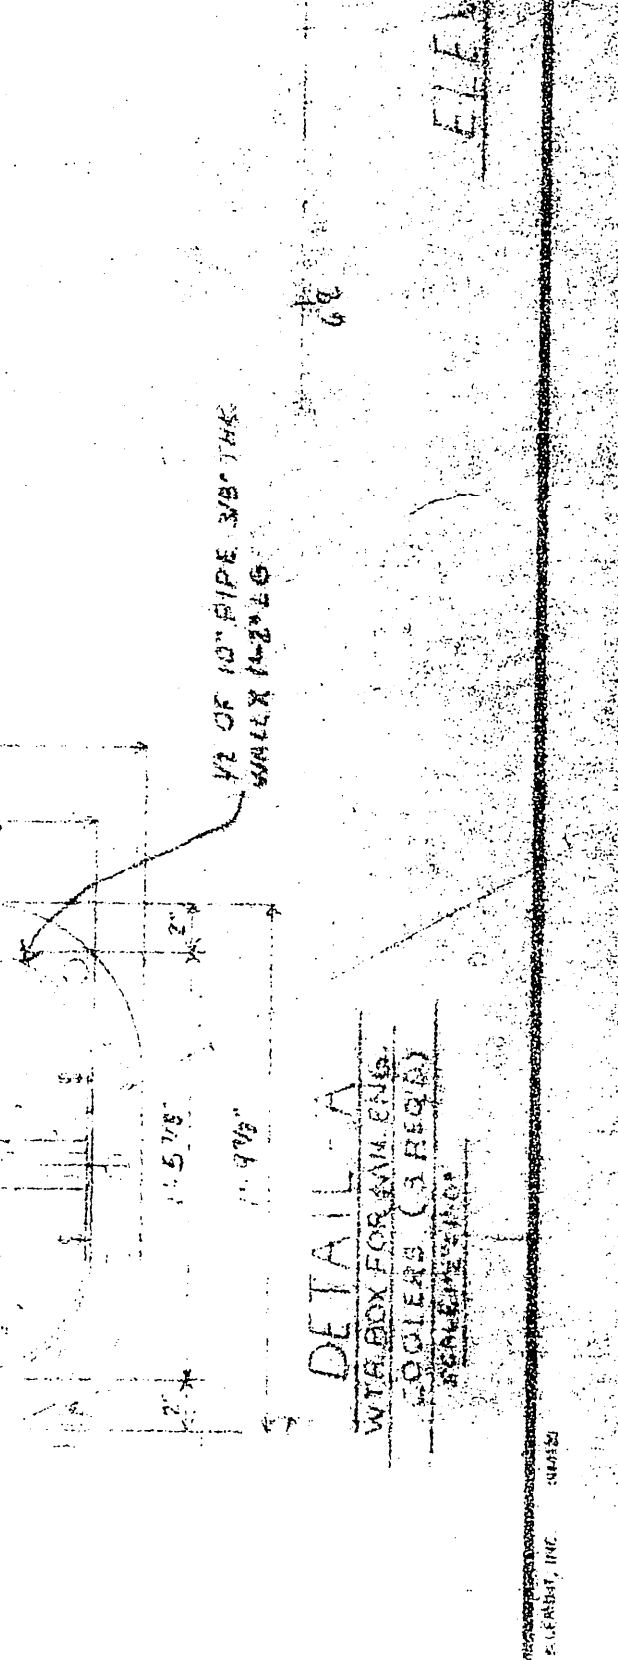
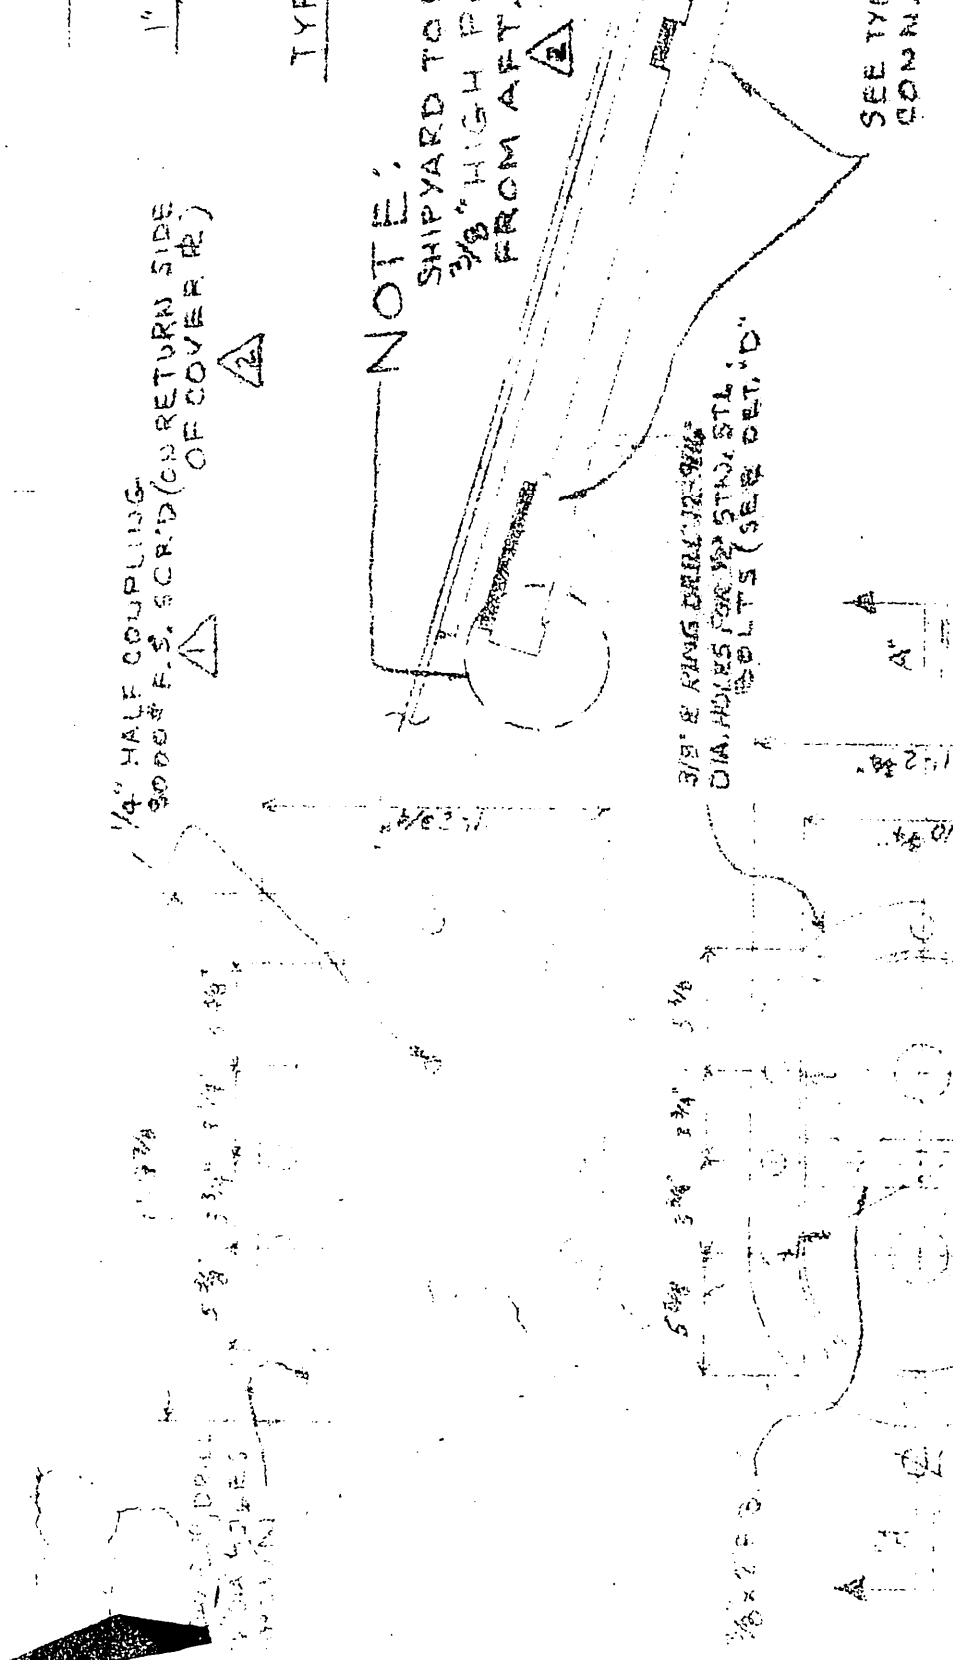
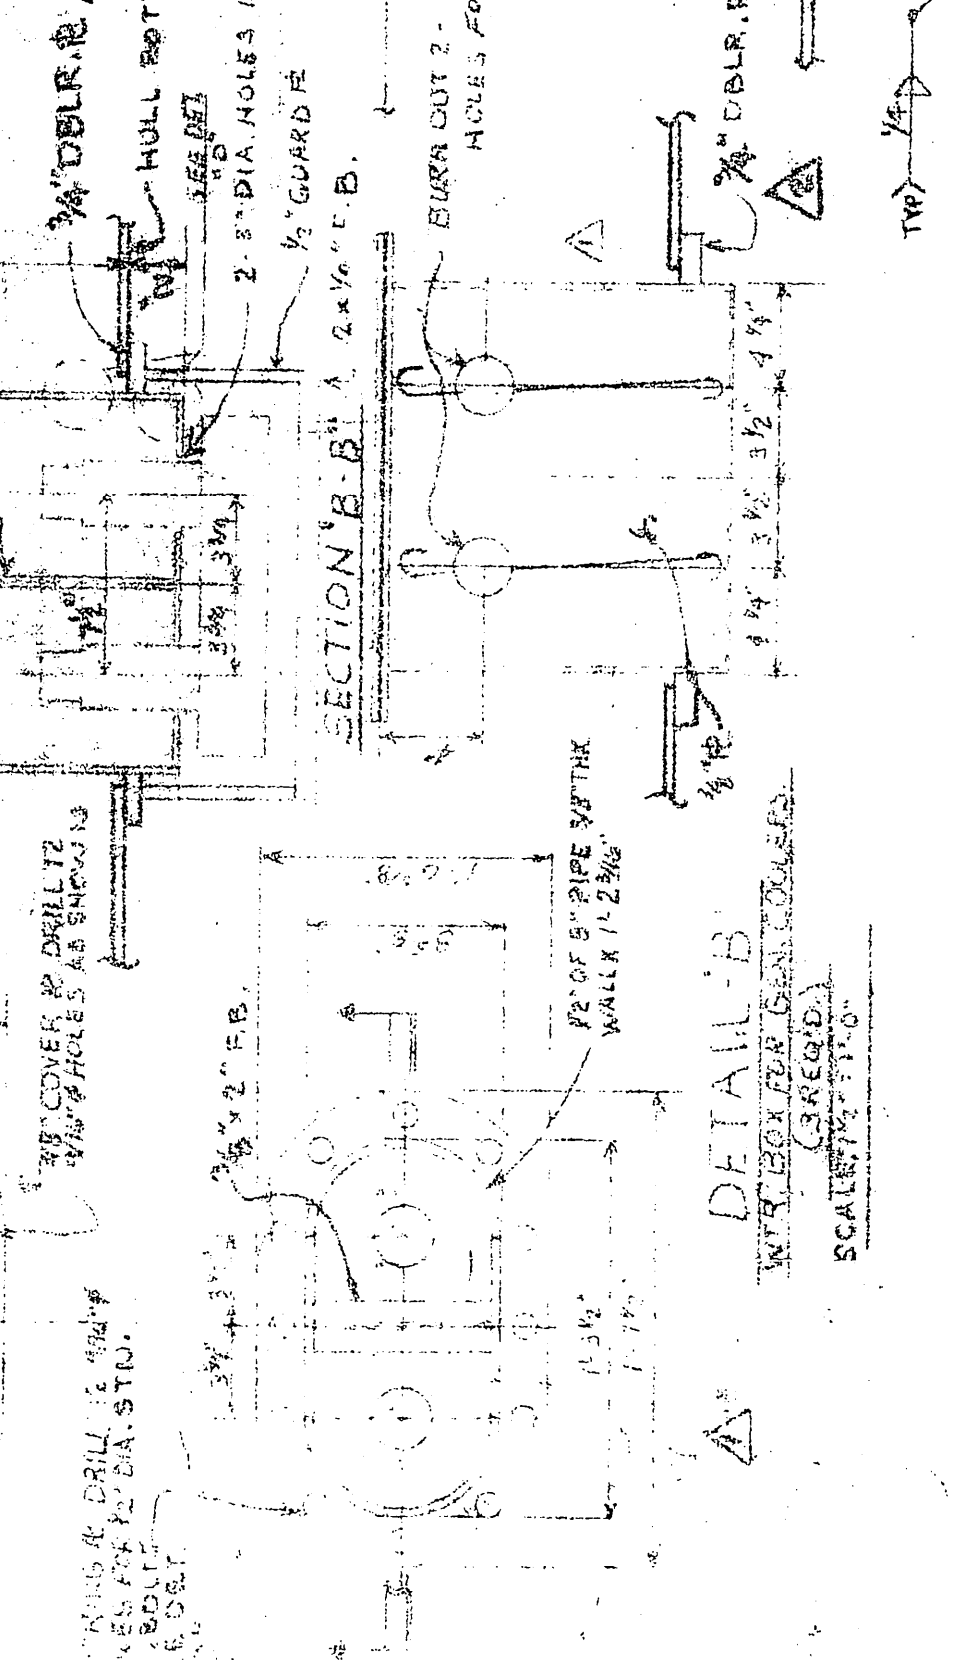
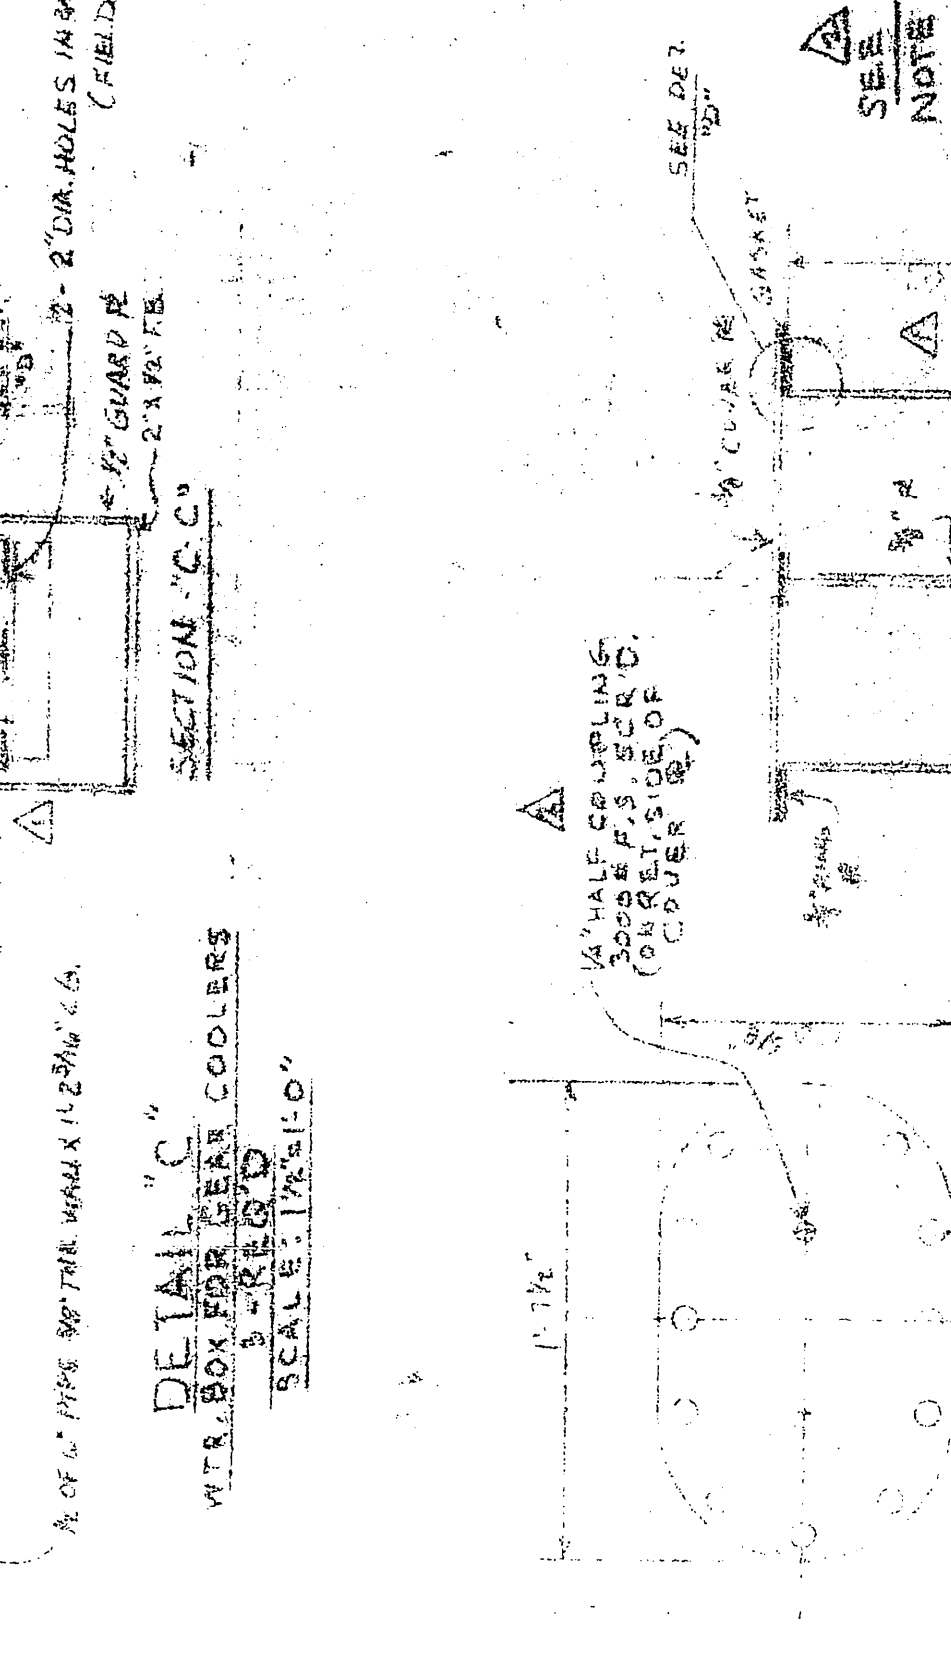
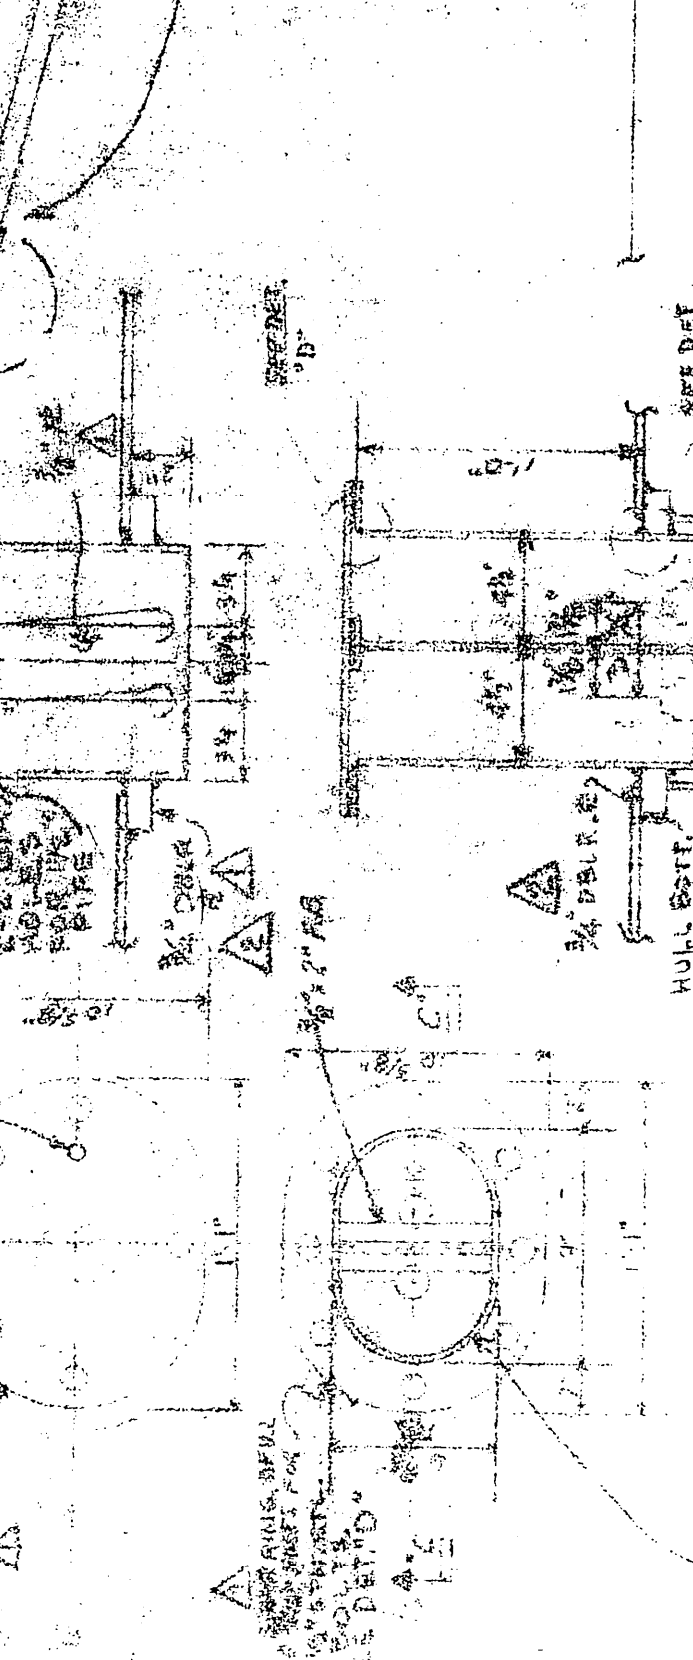
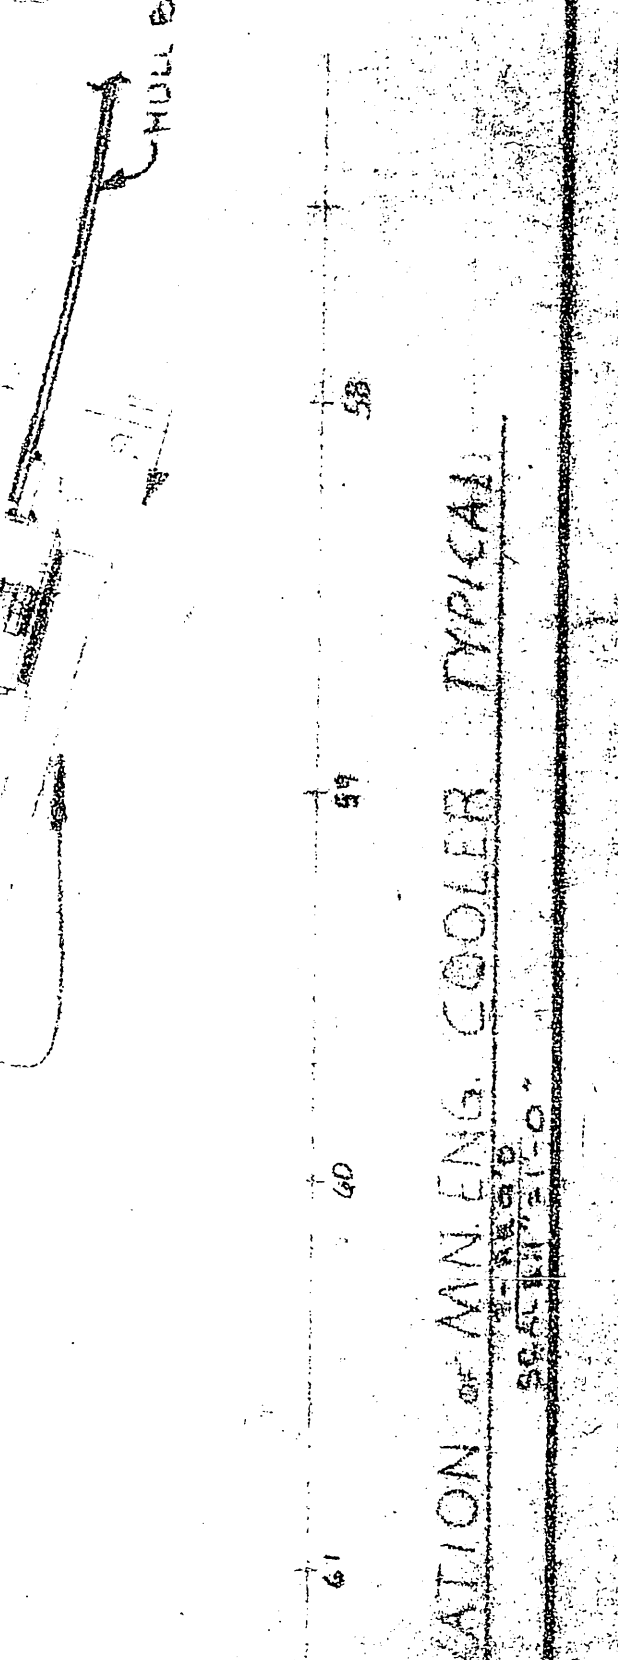
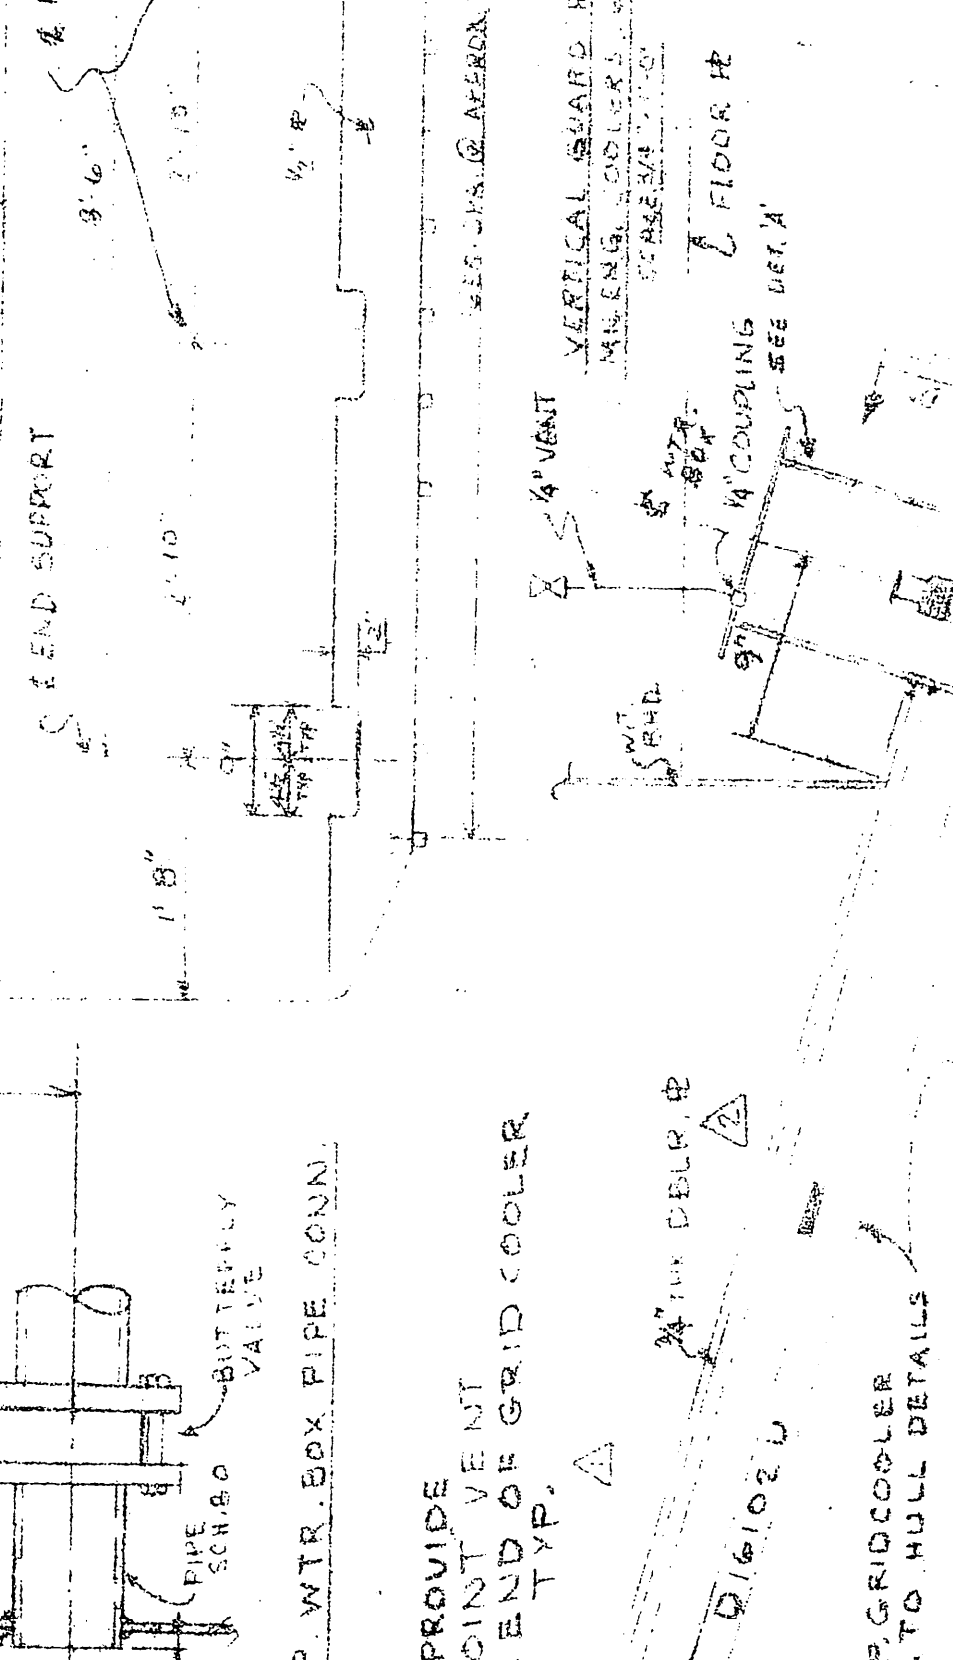
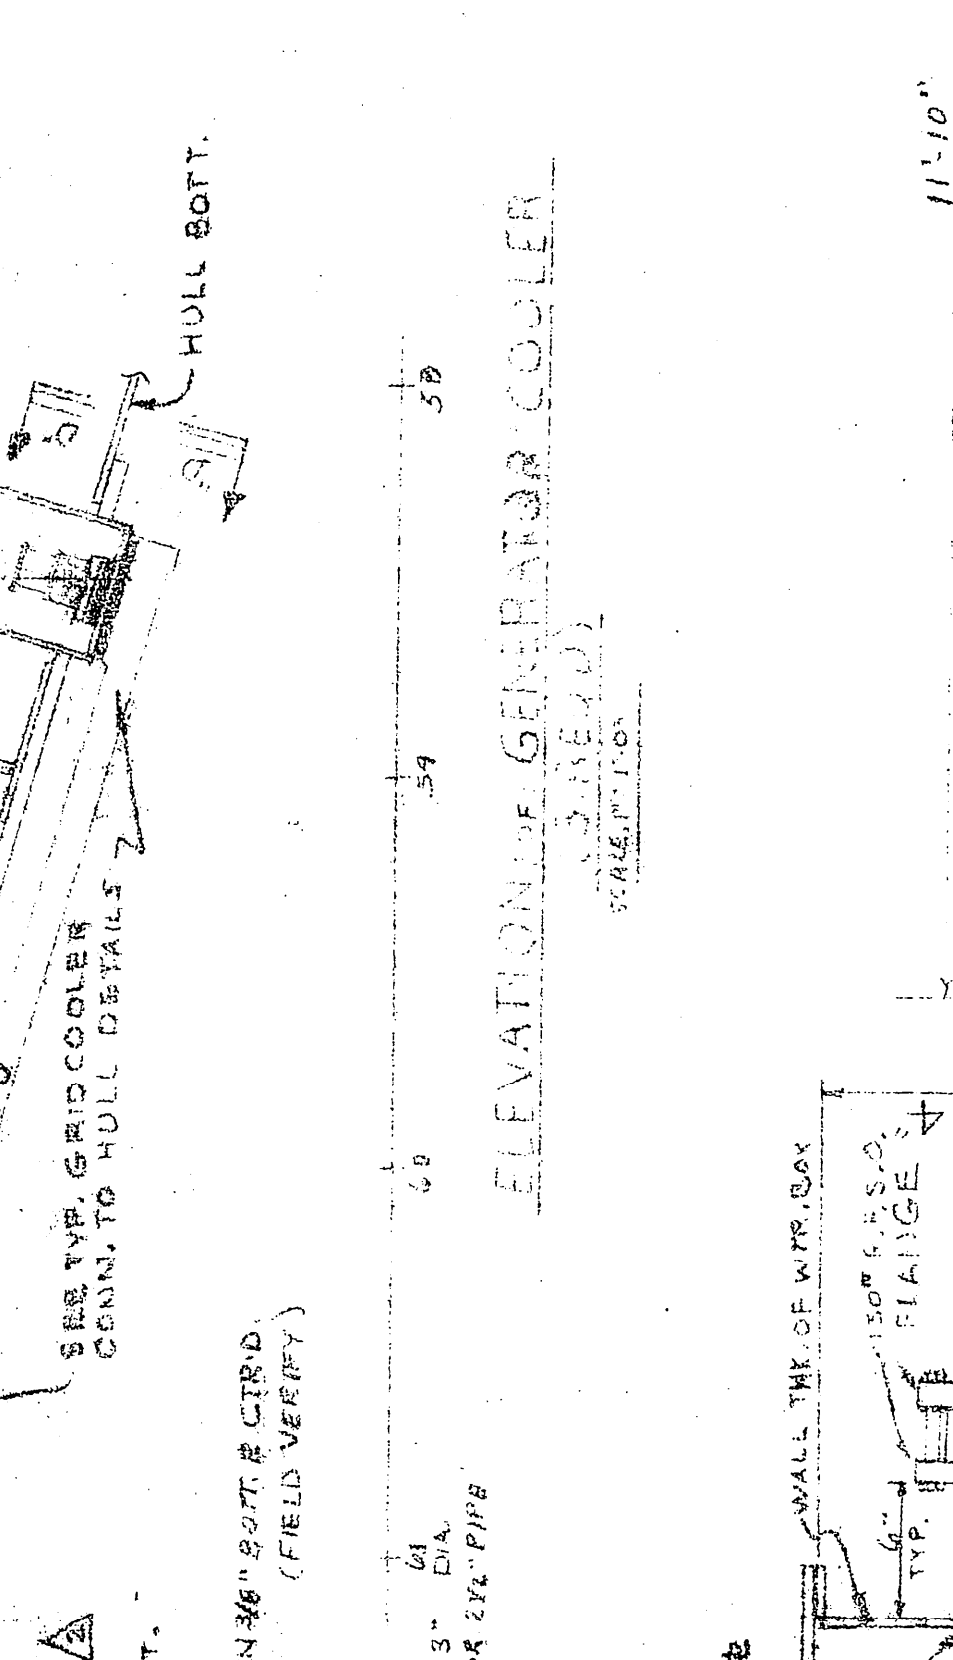
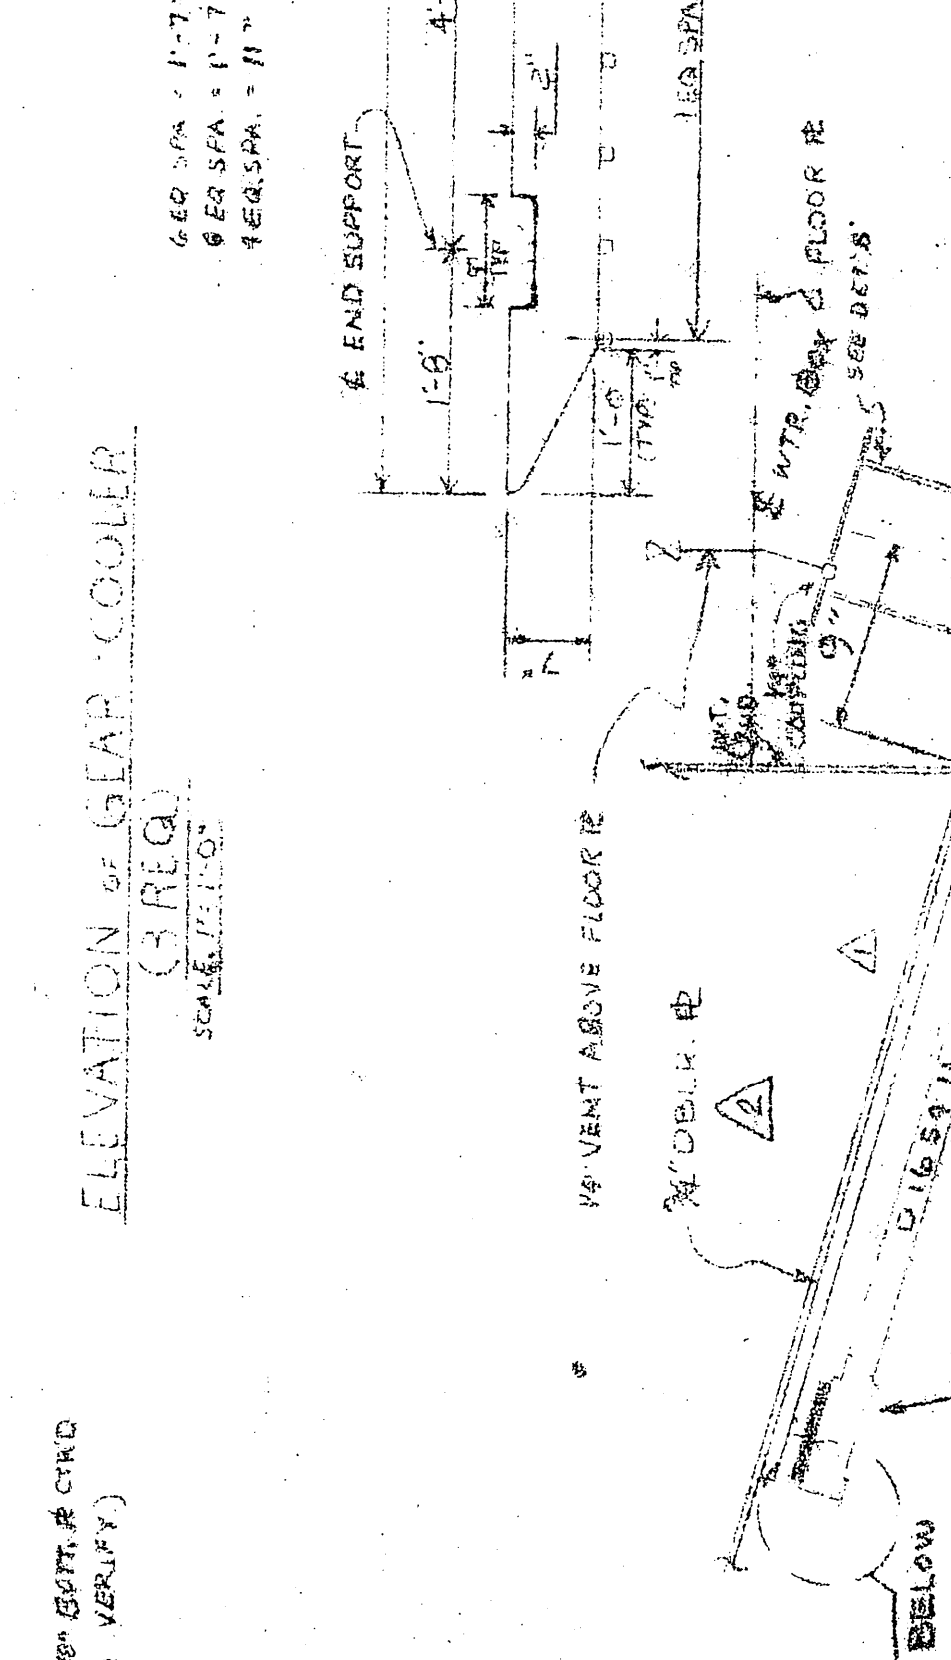
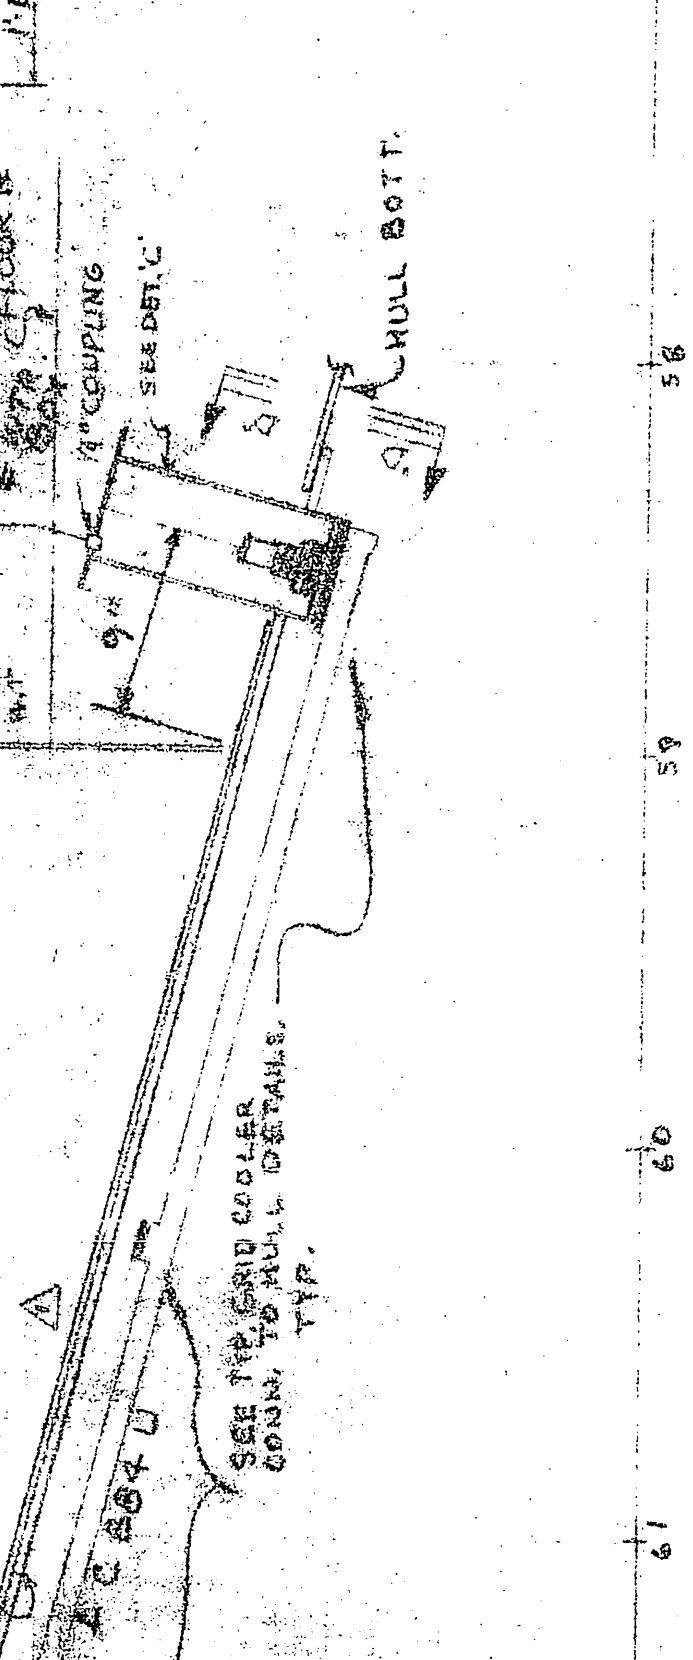
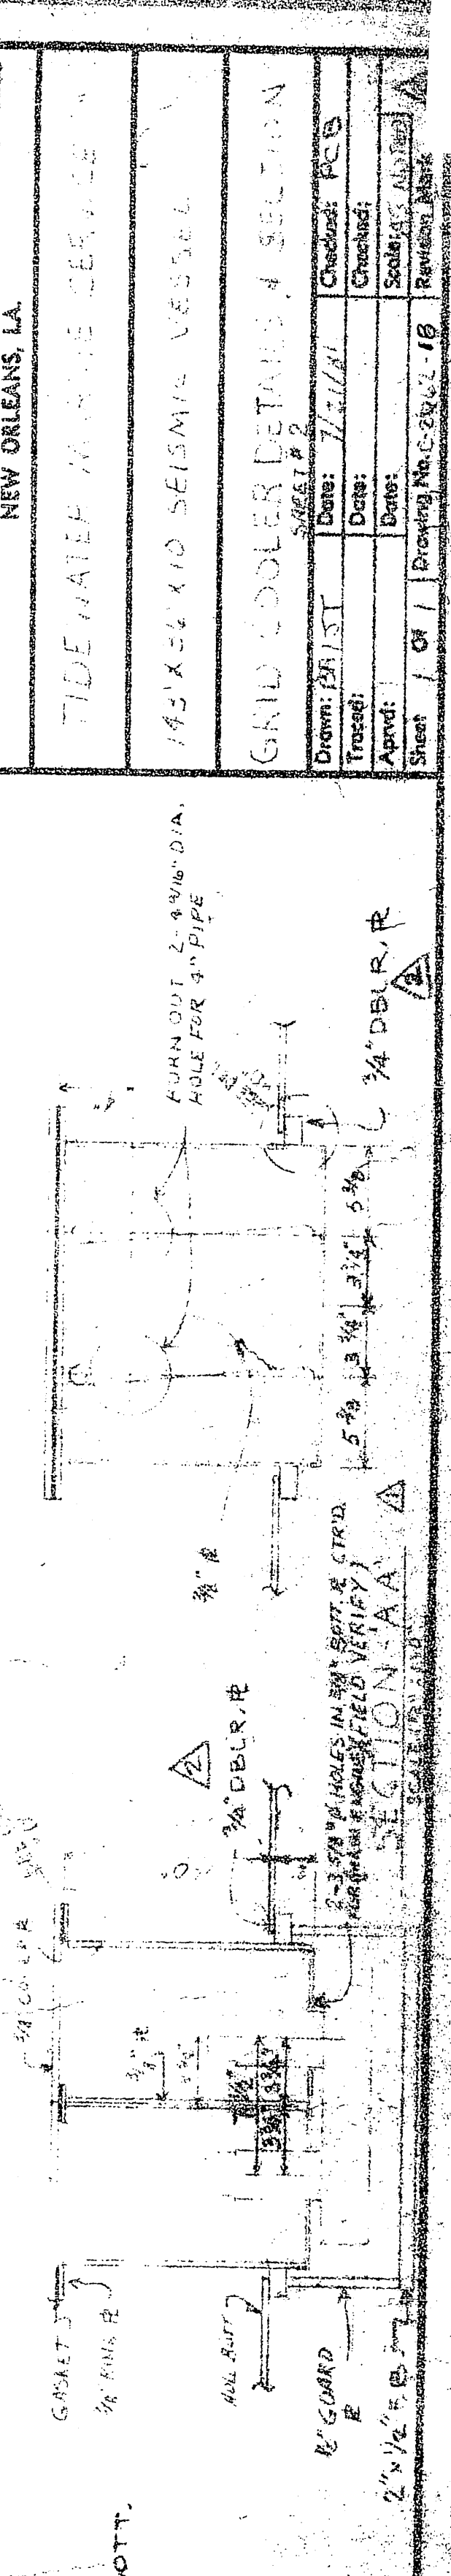
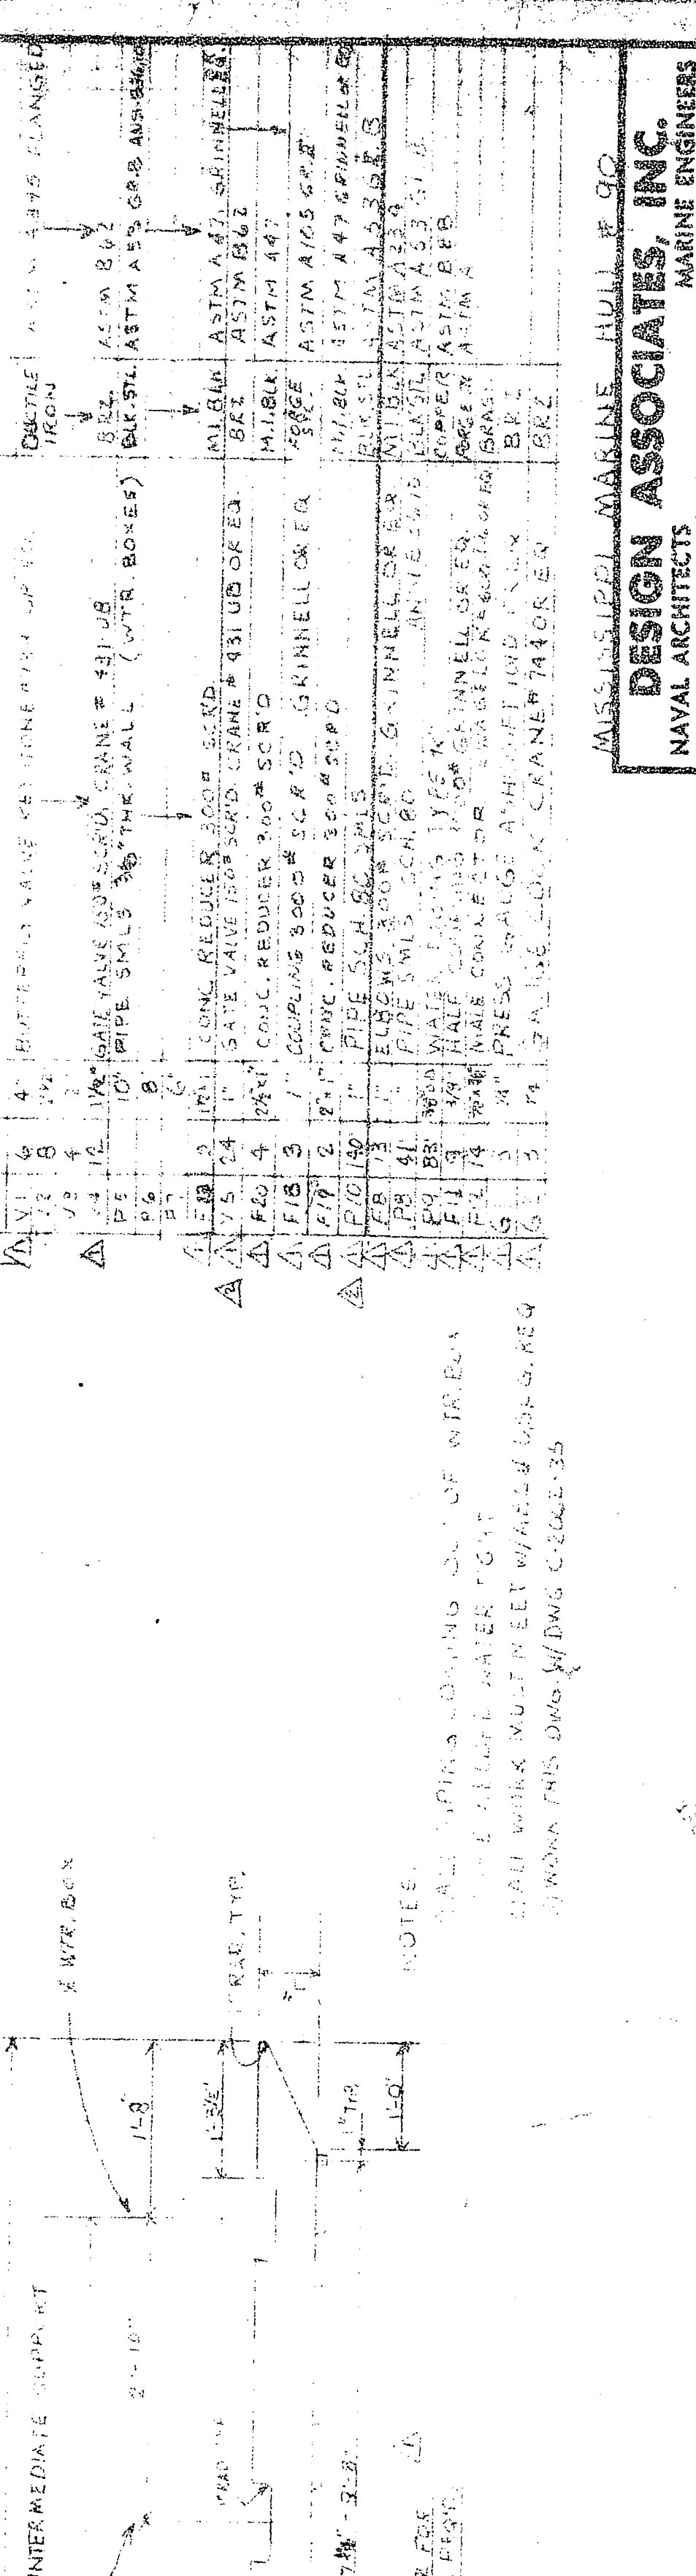
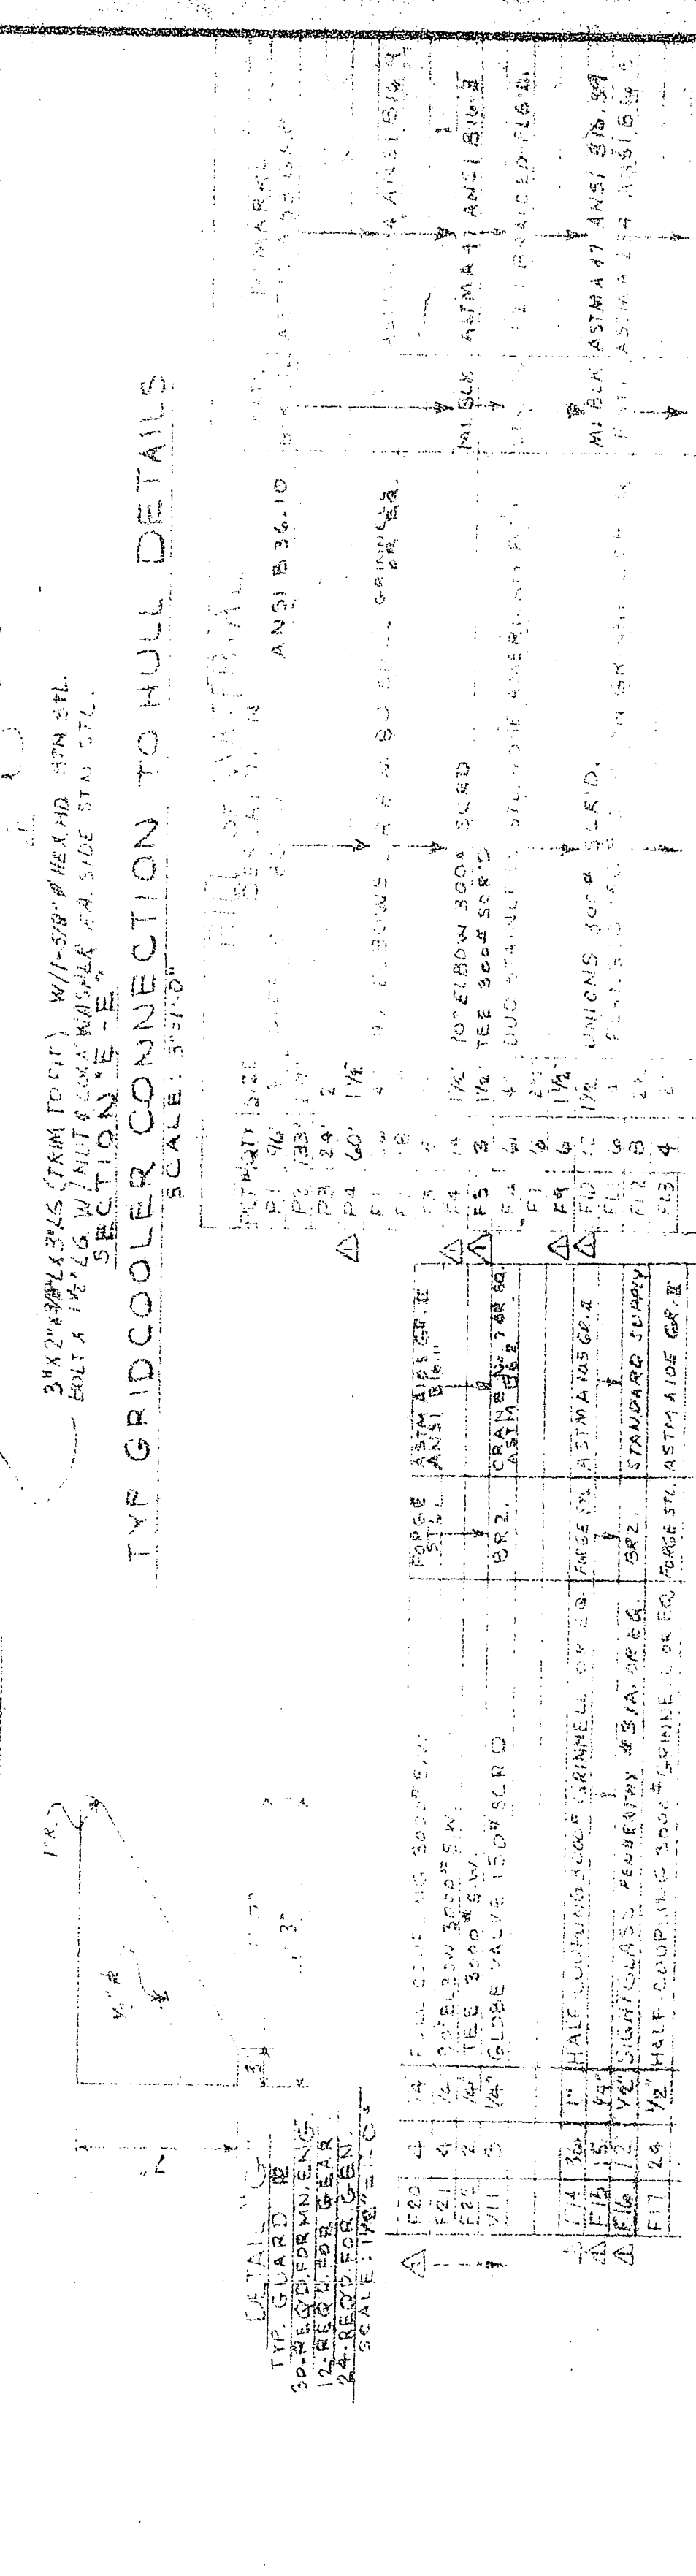
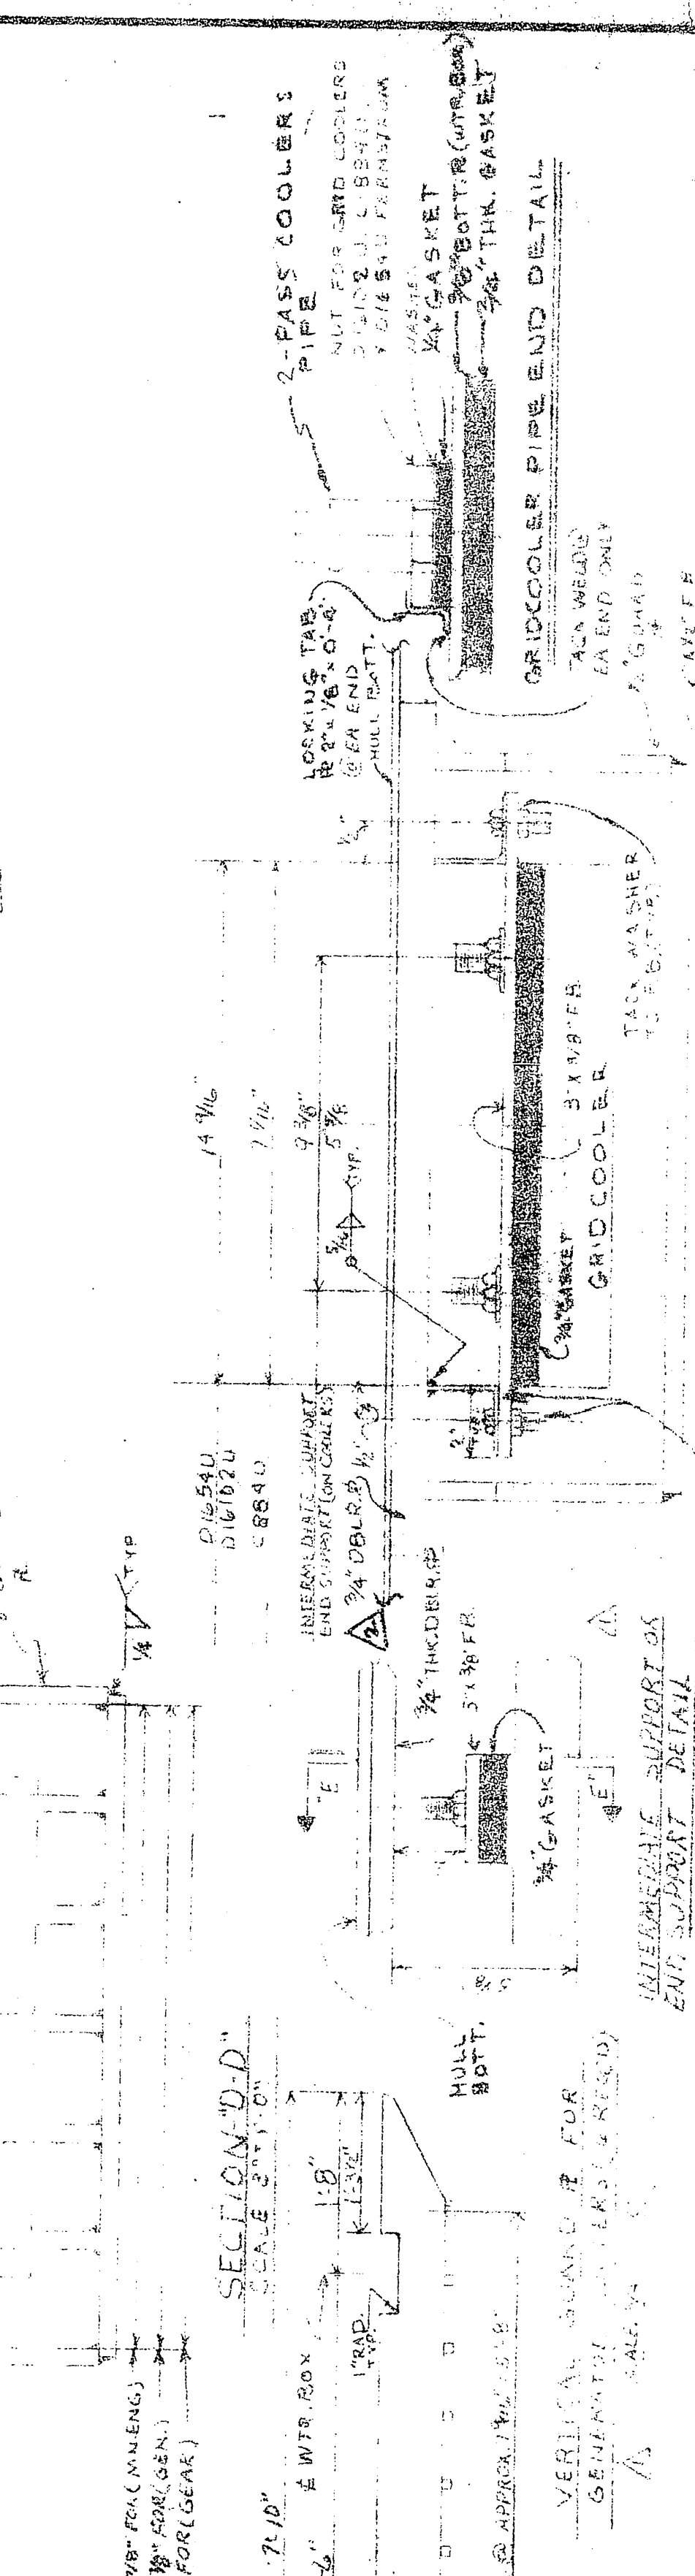


NO.	REV.	DESCRIPTION	BY	DATE
1		REVISED DRAWING PER DAILE (SERVICES MARKED UP PRINT)	MA	10/1/48
2		CHANGED ALL MINOR DET. TO 1/2" DBL. R. REV. DET. TO 1/2" DBL. R. ADDED NOTE TO 1/2" DBL. R. COUPLING ON WTR. BOX COVER RE.	MA	10/1/48

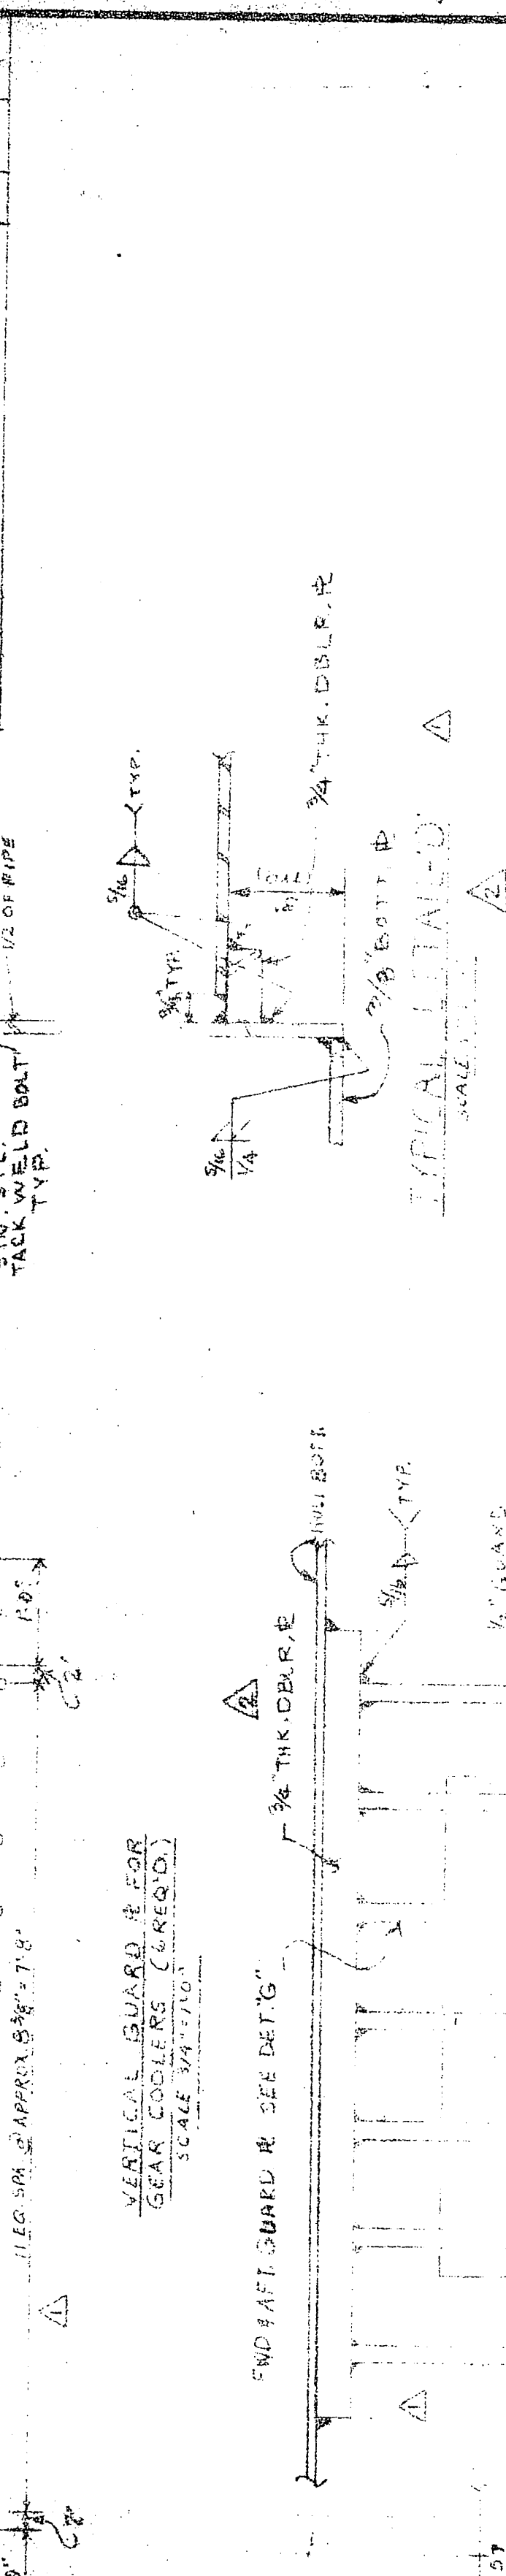

MISSISSIPPI MARINE HULL # 00
DESIGN ASSOCIATES, INC.
 NAVAL ARCHITECTS
 NEW ORLEANS, LA.
 TIDE WATER MARINE SERVICE
 145 X 26 X 10 SEASIDE VESSEL
GRID COOLER DETAILS 4 SECTION

Drawn: JH/ST
 Traced: JH/ST
 Date: 7/1/48
 Date: 7/1/48
 Scale: 1/4" = 1'-0"
 Sheet: 1 of 1
 Drawing No.: 00-20-C-10