

LIST OF COMPARTMENTS AND TANKS NAMEPLATES


DESCRIPTION	QTY	MATL	SIZE	LOCATION	REMARKS
FOREPEAK BALL - 3495 GALS	1	1/2"		M.H. COVER PORT SIDE MAIN DECK AFT FE # 16	BLACK LETTERS
BALLAST TK # 1 - 8175 GALS	1	1/2"		M.H. COVER PORT AND STBD SIDE MAIN DECK MAIN D.K. AFT FE # 14	
BALLAST TK # 2 - 2050 GALS	2	1/2"		M.H. COVER PORT AND STBD SIDE MAIN D.K. AFT FE # 14	
BOW THRUSTER ROOM	1	4		HATCH AT FR. 16, MAIN DECK &	
BALLAST TK # 3 - 11304 GALS	2	3/8"		M.H. COVER PORT SIDE MAIN D.K. AFT FE # 18	BLACK LETTERS
F.O. TK # 1 - 8,201 GALS	2	1/2"		M.H. COVER PORT AND STBD SIDE HOLD	BLACK LETTERS
ESCAPE HATCH	2	1"		M.H. COVER PORT AND STBD SIDE MAIN D.K. AT FE # 27	RED LETTERS
POT. WTR. TK - 8,620 GALS	2	1/2"		M.H. COVER STBD SIDE ON THE FND SIDE OF BHD # 31	WHITE LETTERS
BALLAST TK # 4 - 12,666 GALS	1	1/2"		M.H. COVER STBD SIDE MAIN D.K. AFT FE # 25	BLACK LETTERS
BALLAST TK # 4 - 16,698 GALS	4	1/2"		M.H. COVER PORT SIDE MAIN D.K. AFT FE # 36	
F.O. TK # 2 - 9,427 GALS	2	1/2"		M.H. COVER PORT AND STBD SIDE TUNNEL AFT FE # 35	
F.O. TK # 3 - 6,150 GALS	2	1/2"		M.H. COVER PORT AND STBD SIDE TUNNEL AFT FE # 35	
SEWAGE TK - 5,624 GALS	1	1/2"		M.H. COVER STBD SIDE TUNNEL AFT FE # 45	BLACK LETTERS
SEWAGE TK - 3,100 GALS	1	1/2"		M.H. COVER PORT SIDE TUNNEL AFT FE # 45	WHITE LETTERS
SEWAGE TK - 593 GALS	1	1/2"		M.H. COVER PORT, AFT SIDE OF BHD # 41	WHITE LETTERS
DIRTY L.O. TK - 1451 GALS	1	1/2"		M.H. COVER PORT SIDE AT FE # 52	BLACK LETTERS
L.O. TK - 1450 GALS	3	1/2"		M.H. COVER PORT SIDE AT FE # 52	BLACK LETTERS
F.O. DAY TK - 5,022 GALS	2	1/2"		M.H. COVER PORT AND STBD SIDE AT FE # 54	WHITE LETTERS
BALLAST TK # 5 - 22,487 GALS	4	1/2"		M.H. COVER PORT AND STBD SIDE AT FE # 54	BLACK LETTERS
F.O. TK # 4 - 16,374 GALS	4	1/2"		M.H. COVER PORT AND STBD SIDE AT FE # 54	BLACK LETTERS
F.O. TK # 5 - 1,677 GALS	1	1/2"		M.H. COVER PORT SIDE AFT FE # 83	
F.O. TK # 5 - 2,975 GALS	1	1/2"		M.H. COVER STBD SIDE AFT FE # 83	
AFTPEAK BALLAST TK - 2,508	2	1/2"		M.H. COVER PORT AND STBD AFT FE # 84	BLACK LETTERS
ENG. RM. ESCAPE HATCH	2	1/2"		HATCH, STBD SIDE AT FE # 80 BOTH SIDES	" RED LETTERS "
STEERING RM. ESCAPE HATCH	2	1/2"		HATCH, PORT SIDE AT FE # 80 BOTH SIDES	" RED LETTERS "
ESCAPE HATCH	2	1/2"		IN TUNNELS, AND FND DOOR	RED LETTERS
CHAIN LKR.	2	1/2"		M.H. COVER PORT AND STBD SIDE ON BHD SIDE OF BHD	WHITE LETTERS
TOILET AND SHOWER	4	1/2"		ON DOORS TO HEADS	WHITE LETTERS
SHOWER	1	1/2"		HOLD DK ON DOOR TO SHOWER	
STORE ROOM	1	1/2"		HOLD DK ON DOOR TO STORE RM.	
TUNNEL	5	1/2"		ON DOORS TO TUNNELS	
ENGINE ROOM	3	1/2"		ON DOORS IN TUNNEL	
STEERING ROOM	1	1/2"		ON DOOR IN TUNNEL	
REFRESHING ROOM	1	1/2"		ON AFT SIDE OF DOOR AT FE # 13	
TO GALLEY	2	1/2"		ON DOOR AT LADDER WAYS	
TO HOLD DECK	1	1/2"		ON DOOR AT LADDER WAY	
TO LAB.	1	1/2"			
TO PILOT HOUSE	1	1/2"		ON DOOR AFT SIDE AT FE # 21	WHITE LETTERS
PASSAGEWAY	1	1/2"		ON DOOR AFT SIDE AT FE # 21	BLACK LETTERS
GALLY AND MESS AREA	1	1/2"		ON DOOR AFT SIDE AT FE # 21	BLACK LETTERS
LAB	1	1/2"		ON DOOR AFT SIDE OF HOUSE	
A/C ROOM	1	1/2"		ON DOOR IN LAB	
FOCUSLE DK	1	1/2"		ON DOOR PORT SIDE OF HOUSE AT FE # 30	WHITE LETTERS
PILOT HOUSE	2	1/2"		ON DOOR PORT AND STBD SIDE OF HOUSE	BLACK LTRS
FIRE STATION # 1	1	2"		ON PORT SIDE OF FOCUSLE AT FE # 16	RED LETTERS
FIRE STATION # 2	1	1		ON AFT SIDE OF DK HOUSE PORT SIDE	
FIRE STATION # 3	1	1		ON MAIN D.K. STBD SIDE AT FE # 65	
FIRE STATION # 4	1	1		IN LADDER WAY TO PILOT HOUSE	
FIRE STATION # 5	1	1		IN LADDER WAY TO PASSAGEWAY AT FE # 32	
FIRE STATION # 6	1	2"		IN ENG. RM. AT FE # 65	WITH RED LETTERS
REPAIR LTR.	2	1/2"		ON DOORS TO LABS AT FE # 85	BLACK LTRS
DECK SERVICE BOX # 1	1	1/2"		ON PORT AFT SIDE OF BHD # 35	
DECK SERVICE BOX # 2	1	1/2"		ON PORT AFT SIDE OF BHD # 35	
DECK SERVICE BOX # 3	1	1/2"		ON VENT TRUNK STBD SIDE	
DECK SERVICE BOX # 4	1	1/2"		ON VENT TRUNK PORT SIDE	
DECK SERVICE BOX # 5	1	1/2"		ON BOX STBD SIDE AT FE # 84	BLACK LTRS

CONT.


DESCRIPTION	QTY	MATL	SIZE	LOCATION	REMARKS
DECK SERVICE BOX # 6	1	1/2"		ON BOX PORT SIDE AT FE # 84	BLACK LETTERS
FOREPEAK VENT	1	1		ON DECK @ BASE OF PIPE FR. NO. 7	
FOREPEAK SOUND	1	1		@ SOUND FR. NO. 9 (MINDK)	
BALLAST TK # 1 VENT	1	1		@ BASE OF PIPE FR. NO. 12	
BALLAST TK # 1 SOUND	1	1		@ SOUND FR. NO. 13 (MINDK)	
BALLAST TK # 2 VENT	2	1		@ BASE OF PIPE FR. NO. 17	
BALLAST TK # 2 SOUND	2	1		@ SOUND FR. NO. 11 (MINDK)	
THRUSTER ZM. VENT SUPPLY	1	1		@ BASE OF VENT FR. NO. 17	
THRUSTER ZM. VENT DISCHARGE	1	1		@ BASE OF VENT FR. NO. 17	
BALLAST TK # 3 VENT	2	1		@ BASE OF VENT FR. NO. 22	
BALLAST TK # 3 SOUND	2	1		@ SOUND FR. NO. 22 (MINDK)	
F.O. TANK # 1 VENT	2	1		@ BASE OF PIPE FR. NO. 24	
F.O. TANK # 1 SOUND	2	1		@ SOUND FR. NO. 28 (MINDK)	
POT. WTR. TK. FILL	1	1		@ FILL FR. NO. 36 (MINDK)	
POT. WTR. TK. VENT	1	1		@ BASE OF VENT FR. NO. 35	
BALLAST TK # 5 & VENT	1	1		@ BASE OF VENT FR. NO. 64	
BALLAST TK # 5 & SOUND	1	1		@ SOUND FR. NO. 63 (MINDK)	
BALLAST TK # 4 VENT	2	1		@ BASE OF VENT FR. NO. 44	
BALLAST TK # 4 SOUND	2	1		@ SOUND FR. NO. 47	
F.O. TK # 2 VENT	2	1		@ BASE OF VENT FR. NO. 36	
F.O. TK # 2 SOUND	2	1		ON TANK TOP IN TUNNEL @ FR. NO. 39	
F.O. TK # 3 VENT	2	1		ON D.K. @ FR. NO. 44	
F.O. TK # 3 SOUND	2	1		ON TANK TOP @ FR. NO. 39	
SEWAGE TK. SOUND	1	1		" " @ FR. NO. 44	
SEWAGE TK. VENT	1	1		@ BASE OF VENT IN STACK FR. NO. 32	
DIRTY L.O. VENT	1	1		ON DECK @ BASE OF VENT FR. NO. 51	
L.O. VENT	3	1		ON DECK @ BASE OF VENT FR. NO. 54 & 51	
DAY TANK VENT	2	1		ON DECK @ BASE OF VENT FR. NO. 61	
PANTRY	1	1		OVER DOOR @ FR. NO. 13 (MINDK)	WHITE LETTERS
HEAD & SHOWERS	1	1		OVER DOOR @ FR. NO. 18 (MINDK)	
F.O. TK # 4 VENT	2	1		ON DECK @ BASE OF VENT FR. NO. 73	BLACK LETTERS
F.O. TK # 4 SOUND	2	1		@ SOUND FR. NO. 65	
F.O. TK # 5 VENT	2	1		@ BASE OF VENT	
F.O. TK # 5 SOUND	2	1		@ SOUND FR. NO. 83 (MINDK)	
AFTPEAK BALLAST VENT	2	1		@ BASE OF VENT FR. NO. 84	
AFTPEAK BALLAST SOUND	2	1		@ SOUND - & FR. NO. 84	
TOILET	1	1		OVER DOOR @ FR. NO. 19 (HOLD)	WHITE LETTERS
MASTER'S ST. RM.	1	1		@ FR. NO. 21 (FOCUSLE DK)	
CHIEF SCIENTIST ST. RM.	1	1		@ FR. NO. 21 (FOCUSLE DK)	
LOCKER	2	1		@ FR. NO. 36 (MINDK) 1/5	BLACK LETTERS
MATE'S ST. RM.	1	1		@ FR. NO. 14 (MINDK)	WHITE LETTERS
ENGINEER'S ST. RM.	1	1		@ FR. NO. 18 (MINDK)	
CREW'S ST. RM.	2	1		@ FR. NO. 14 (MINDK)	
SCIENTIST'S ST. RM.	2	1		@ FR. NO. 21 & 23 (MINDK)	
DIRTY L.O. SOUND	1	1/2"		ON MINDK @ FR. NO. 51	BLACK LETTERS
SCIENTIST'S ST. RM.	2	1/2"		OVER DOOR @ FR. NO. 24 & 28 (HOLD)	WHITE LETTERS
EMER. STOP - BLOWERS	1	1/2"		ON MINDK AT FR. NO. 24 NEXT TO DOOR	RED LETTERS
EMER. STOP - FUEL OIL PUMP	1	1/2"		ON MINDK AT FR. NO. 24 NEXT TO DOOR	RED LETTERS
POTABLE WTR. HOSE	1	1/2"		ON POTABLE WTR. HOSE RACK	RED LETTERS
POTABLE WTR. HOSE SHALL BE DISCONNECTED WHEN NOT USED	1	1/2"		ON POTABLE WTR. HOSE RACK	RED LETTERS
RADAR J.B.	1	PLSTC		IN CONSOLE P.H.	BLACK PLST. w/ WHITE LTRS.
RADAR POWER SUPPLY	2	PLSTC		ON UNIT IN A/C ROOM	BLACK PLST. w/ WHITE LTRS.
SHORE POWER REEL	1	1/2"		ON REAL AFT. OF DECK HOUSE	BLACK LTRS.
INT'L FIRE HOSE CONN.	2	1/2"		MINDK. 1/5 AT VENT	RED LTRS.
LATHE	1	1/2"		IN ENG. ROOM	BLACK LTRS.
FISHER CHLORINATOR	1	1/2"		ON UNIT IN TUNNEL	BLACK LTRS.

GENERAL NOTES

- ALL LABELS SHALL BE ATTACHED WITH SCREWS OR RIVETS.
- FOR PIPING & VALVE LABEL PLATES, SEEDWGS: M4 PART II.
- PLATES TO CONTRAST WITH COLOR OF LETTERS.
- AT BACK INSTRUCTIONS, POSTER, TO BE PLACED ON BHD IN PASSAGE TO PILOT HOUSE.
- POSTERS IN GEN. NOTE NO. 415 ARE TO BE FRAMED IN WOOD AND UNDER PLEXIGLASS.
- CERTIFICATES FROM REGULATORY BODIES ARE TO BE FRAMED AND PLACED IN PILOT HOUSE ON AFT. BHD. STBD. SIDE.
- QTY SHOWN ARE FOR 1 ONE BOAT ONLY, QTY FOR TWO - BOATS ARE REQUIRED.

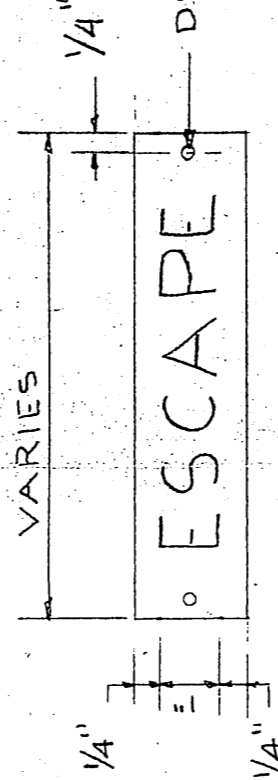

TYP NAME PLATE

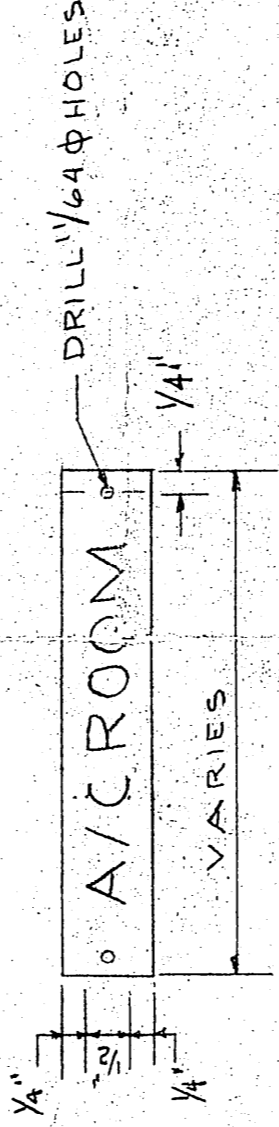

TYP NAME PLATE

REV	DESCRIPTION	DATE	BY
4	AS BUILT	1/13/73	
3	MODIFIED POTABLE WTR. HOSE F. POST. WTR. HOSE SHALL BE ONE WHEN NOT IN USE. FR. NO. 50.	1-15-73	
2	ADDED GEN. NOTE NO. 517	1/29/73	
1	ADDED NOTE NO. 3 AND REVISED MATL. TO ALUMINUM. PRE-DEVELOPERS	9-14-72	

APPROVALS
USCG
USPHS

OFFICE COPY

U.S. NAVAL SHIP SYSTEMS COMMAND
WASHINGTON D.C. 20360

OCEANOGRAPHIC RESEARCH SHIP
AGOR (UTILITY) CLASS

HALTER MARINE SERVICES, INC.
P.O. BOX 28466 NEW ORLEANS, LA. 70189

LABEL PLATES SHEET 1 of 4
COMPTS, TANKS, BHD & MISC.

SCALE	DRAWN BY	DATE	CHKD BY	DWG. NO.
		8/13/73		
HALTER	DATE	BY	NO.	REV.
HALTER	8/13/73		4	
DRAWING	8/13/73		4	
HALTER	8/13/73		4	
DRAWING	8/13/73		4	
HALTER	8/13/73		4	
DRAWING	8/13/73		4	
HALTER	8/13/73		4	
DRAWING	8/13/73		4	

00025