


REVISIONS				
ZONE	REV	DESCRIPTION	DATE	APPROVED
A	AS BUILT		11/10/95	
B	ADDED K4C,K1A,K9A,K9C	— REMOTE WIRE CHANGE.	03/24/08	

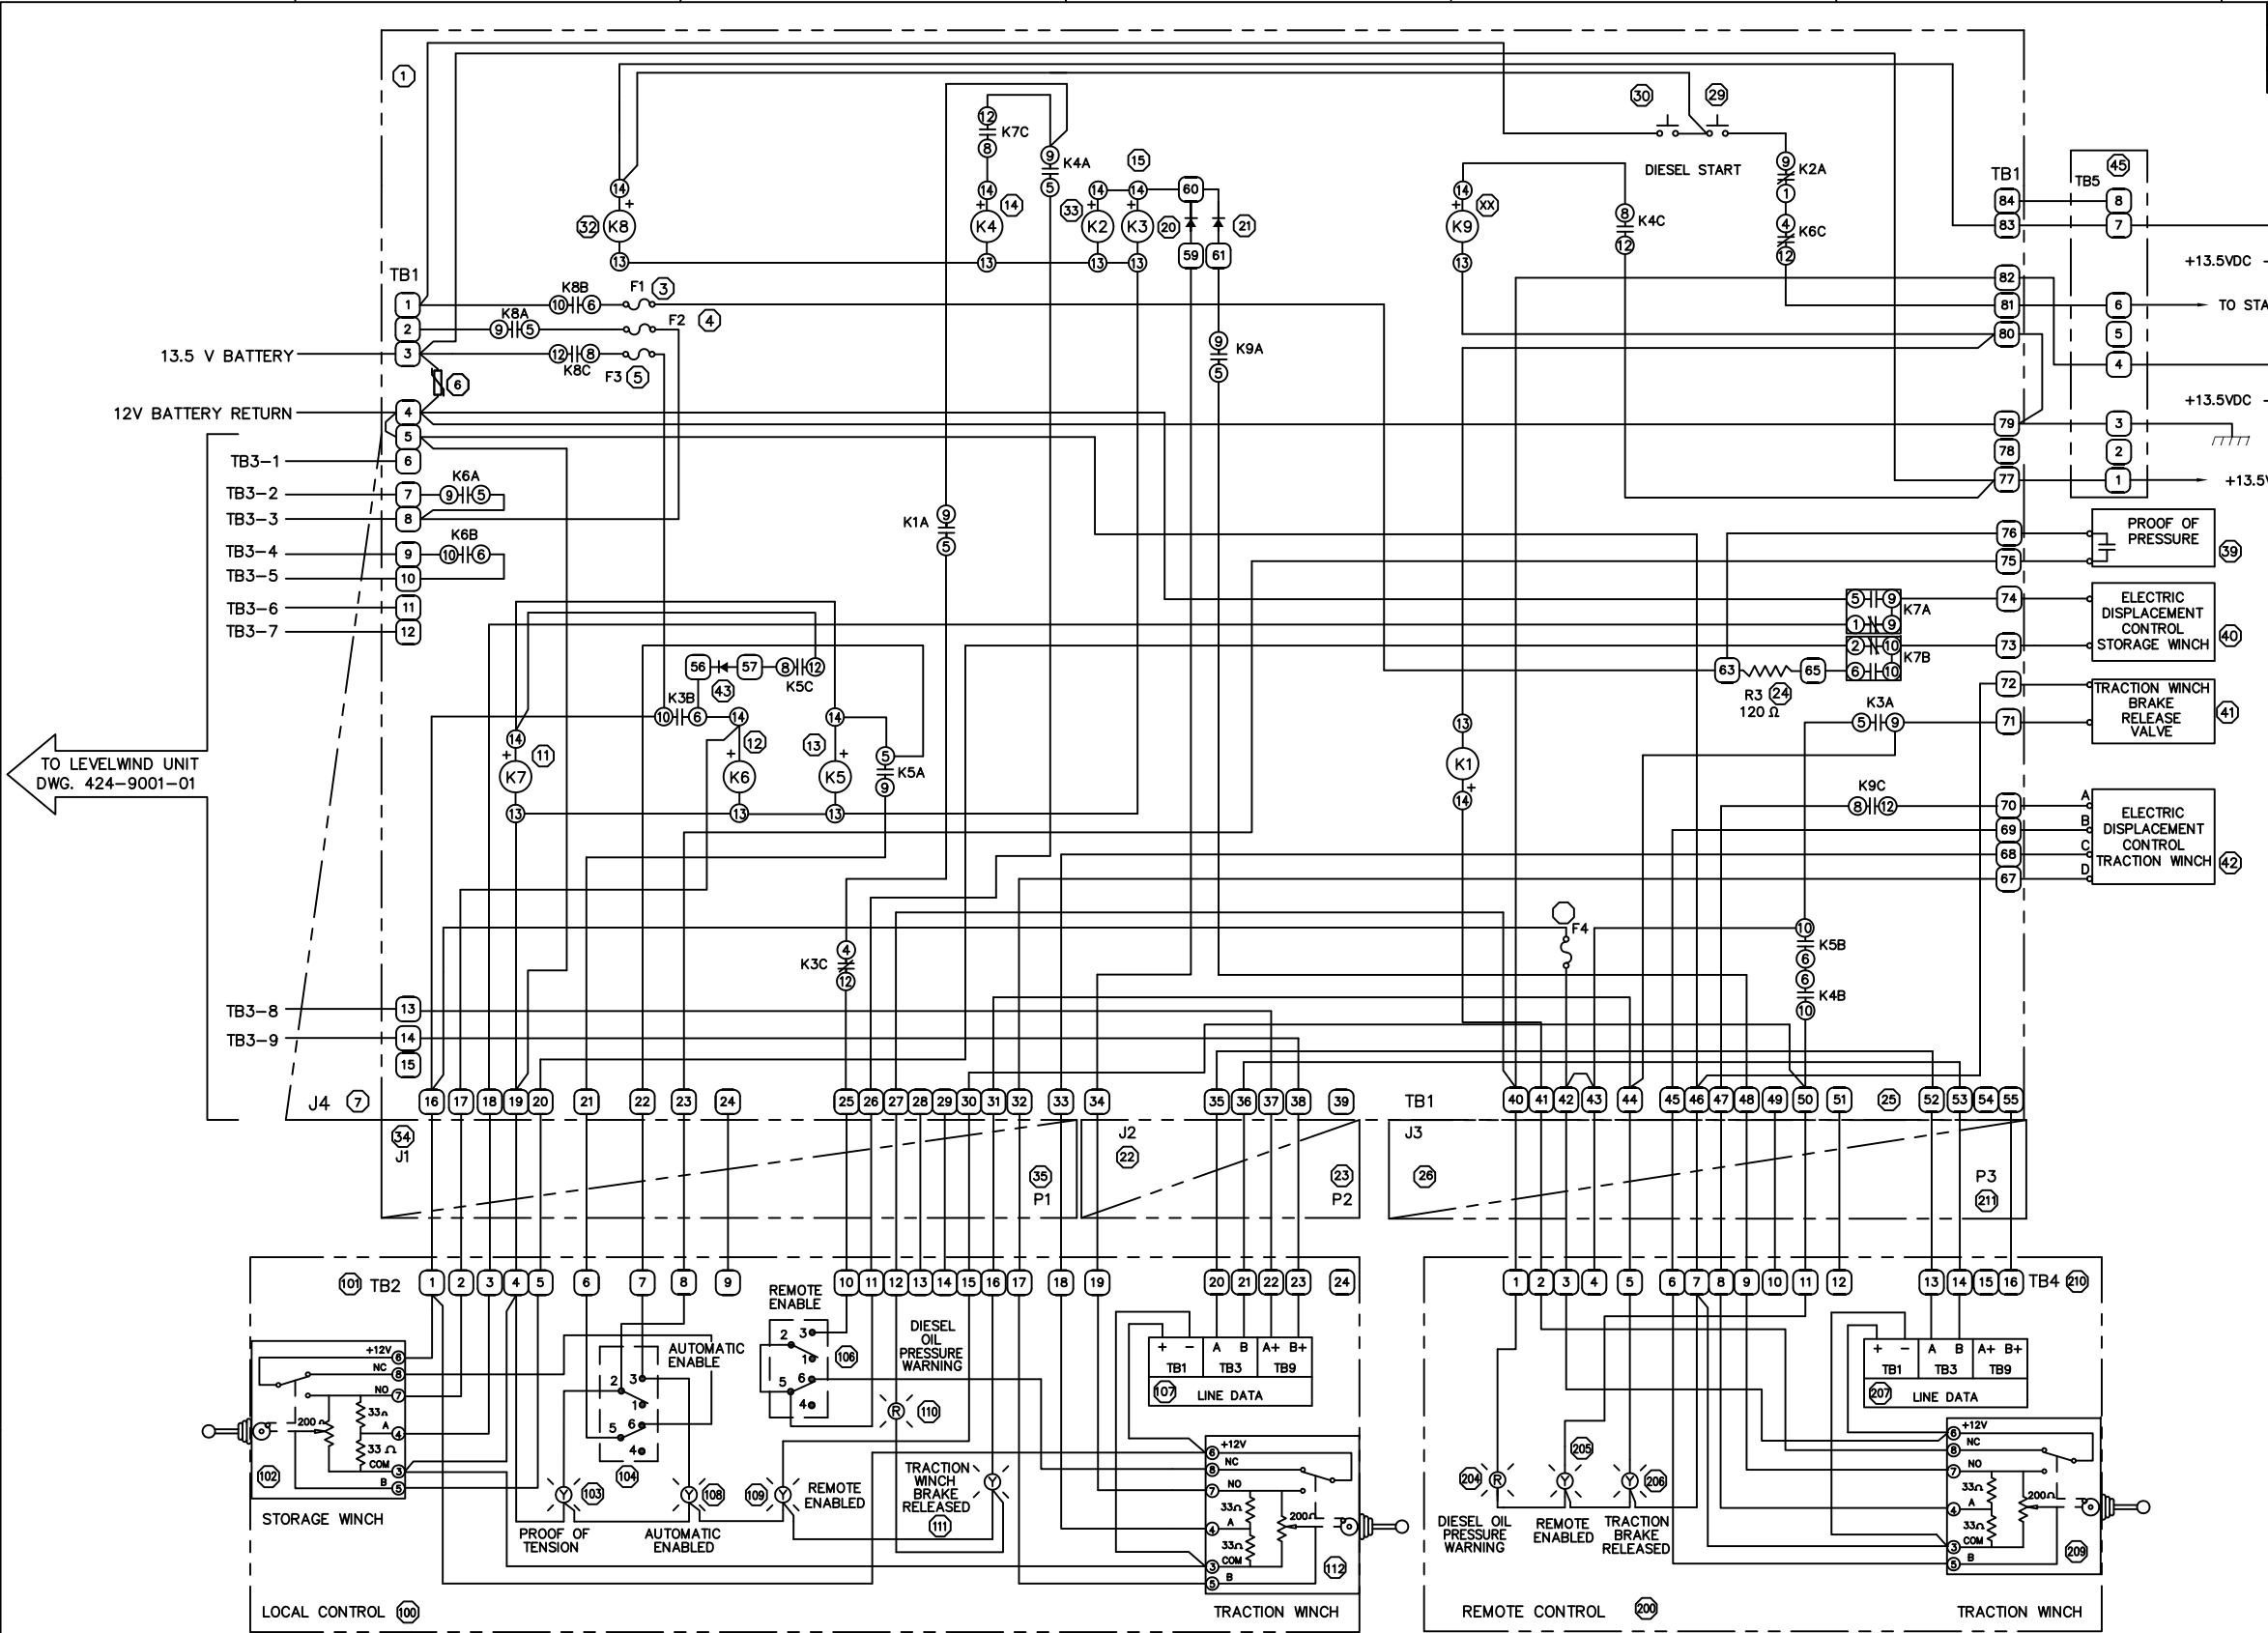

- K1. REMOTE CONTROL I/L
A. REMOTE OUT OF NEUT. I/L OVER REMOTE ENABLE
B. —
C. —
- K2. TW BRAKE REL.
A. HPU START INTERLOCK (NC)
B. —
C. —
- K3. TW BRAKE REL.
A. TW BRAKE REL.
B. STORAGE WINCH BREAK REL.
C. REMOTE ENABLE INTERLOCK (NC)
- K4. REMOTE ENABLE.
A. LATCH
B. REMOTE INDICATOR LAMP.
C. —
- K5. AUTOMATIC MODE.
A. LATCH
B. REMOTE ENABLE INDICATOR LAMP(ON REMOTE)
C. STORAGE WINCH RELEASE.
- K6. STORAGE WINCH BREAK REL.
A. STORAGE WINCH BRAKE RELEASE.
B. LEVEL WIND ENABLE.
C. STORAGE WINCH BRAKE OVER START INTERLOCK.
- K7. AUTOMATIC MODE.
A. STORAGE WINCH EDC STEERING.
B. STORAGE WINCH EDC STEERING.
C. AUTOMATC MODE OVER REMOTE ENABLE INTERLOCK.
- K8. 13.7VDC POWER RELAY.
A. 13.7VDC TO LW ASSY.
B. 13.7VDC TO DEC BIAS RESISTOR.
C. 13.7VDC TO HPU ENCLOSURE.
- K9. K4 SLAVE. (REMOTE ENABLE)
A. REMOTE TW BRAKE I/L
B. —
C. REMOTE OVER EDC I/L

UNLESS OTHERWISE SPECIFIED: DIMENSIONS ARE IN INCHES. TOLERANCES ARE: FRACTIONS DECIMALS ANGLES ± .XX ± ± ± .XXX ± ±		CUSTOMER P.O. No. DYNACON JOB No. 425		THIS DRAWING IS THE PROPERTY OF DYNACON, INC. 831 INDUSTRIAL BLVD. BRYAN, TEXAS USA 77803 ANY REPRODUCTION OR USE OF THIS DESIGN IS EXPRESSLY FORBIDDEN UNLESS AUTHORIZED IN WRITING.	
REMOVE BURRS, BREAK SHARP EDGES.		APPROVALS		DATE	
MATERIAL 425-9009-01		DRAWN DRB		08/15/95	
FINISH		DRAFTING CHECK DRB		08/21/95	
DO NOT SCALE DRAWING		ENGINEERING CHECK MC		08/21/95	
		ENGINEERING APPROVAL JRJ		08/21/95	
		PRODUCTION APPROVAL MJS		08/21/95	
		SIZE CAGE CODE		DWG NO.	
		D OFSDO		425-9001-01	
		SCALE 1/1		PATH J:\425\42590101	
				SHEET 1 OF 1	

11/10/95 07:31