REV. MK.	DESCRIPTION	BY	DATE	APRVD.
1	FOCSLE DECK BEAMS REVISED TO I 9x3x3/8 PER YARD FABRICATION, & GIRDER & DEEP BEAM AT FR 20 ADDED TO AGREE WITH AS BUILT.	RB	5/14/81	[illegible]
2	REVISED PILOT HOUSE PLAN & RELATED SECTIONS TO SUITE SHIPYARD DWG.	RN	6-1-81	ALS
3	MADE CORRECTIONS PER MARKED UP PRINT BY HUGH SMITH	M. B.	7/9/81	ALS

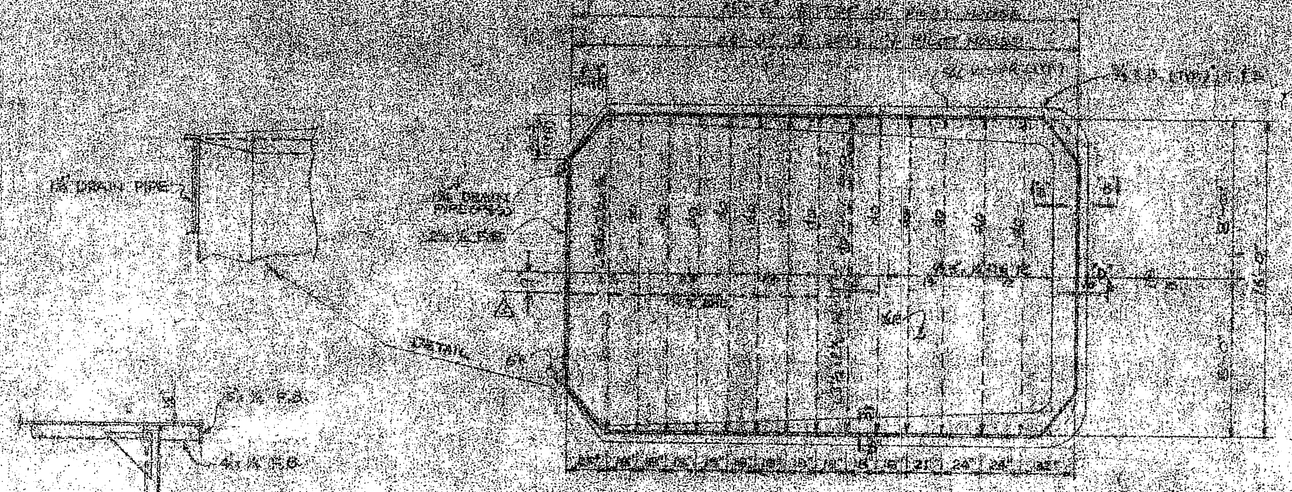

TYPICAL DETAIL
SCALE: 3/8" = 1'-0"

FOCSLE DECK TOP PLATE
SCALE: 1/2" = 1'-0"

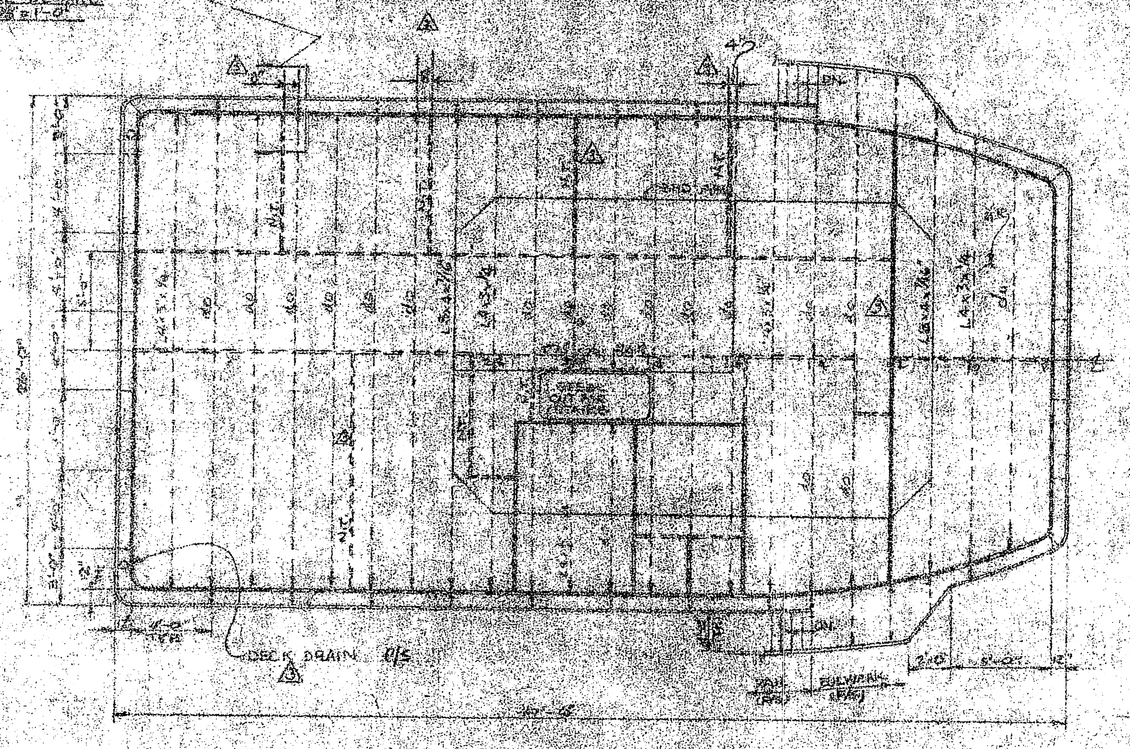
DECK DRAIN P/S
2'-0" R.O.T.
2'-0"
2'-0"
2'-0"