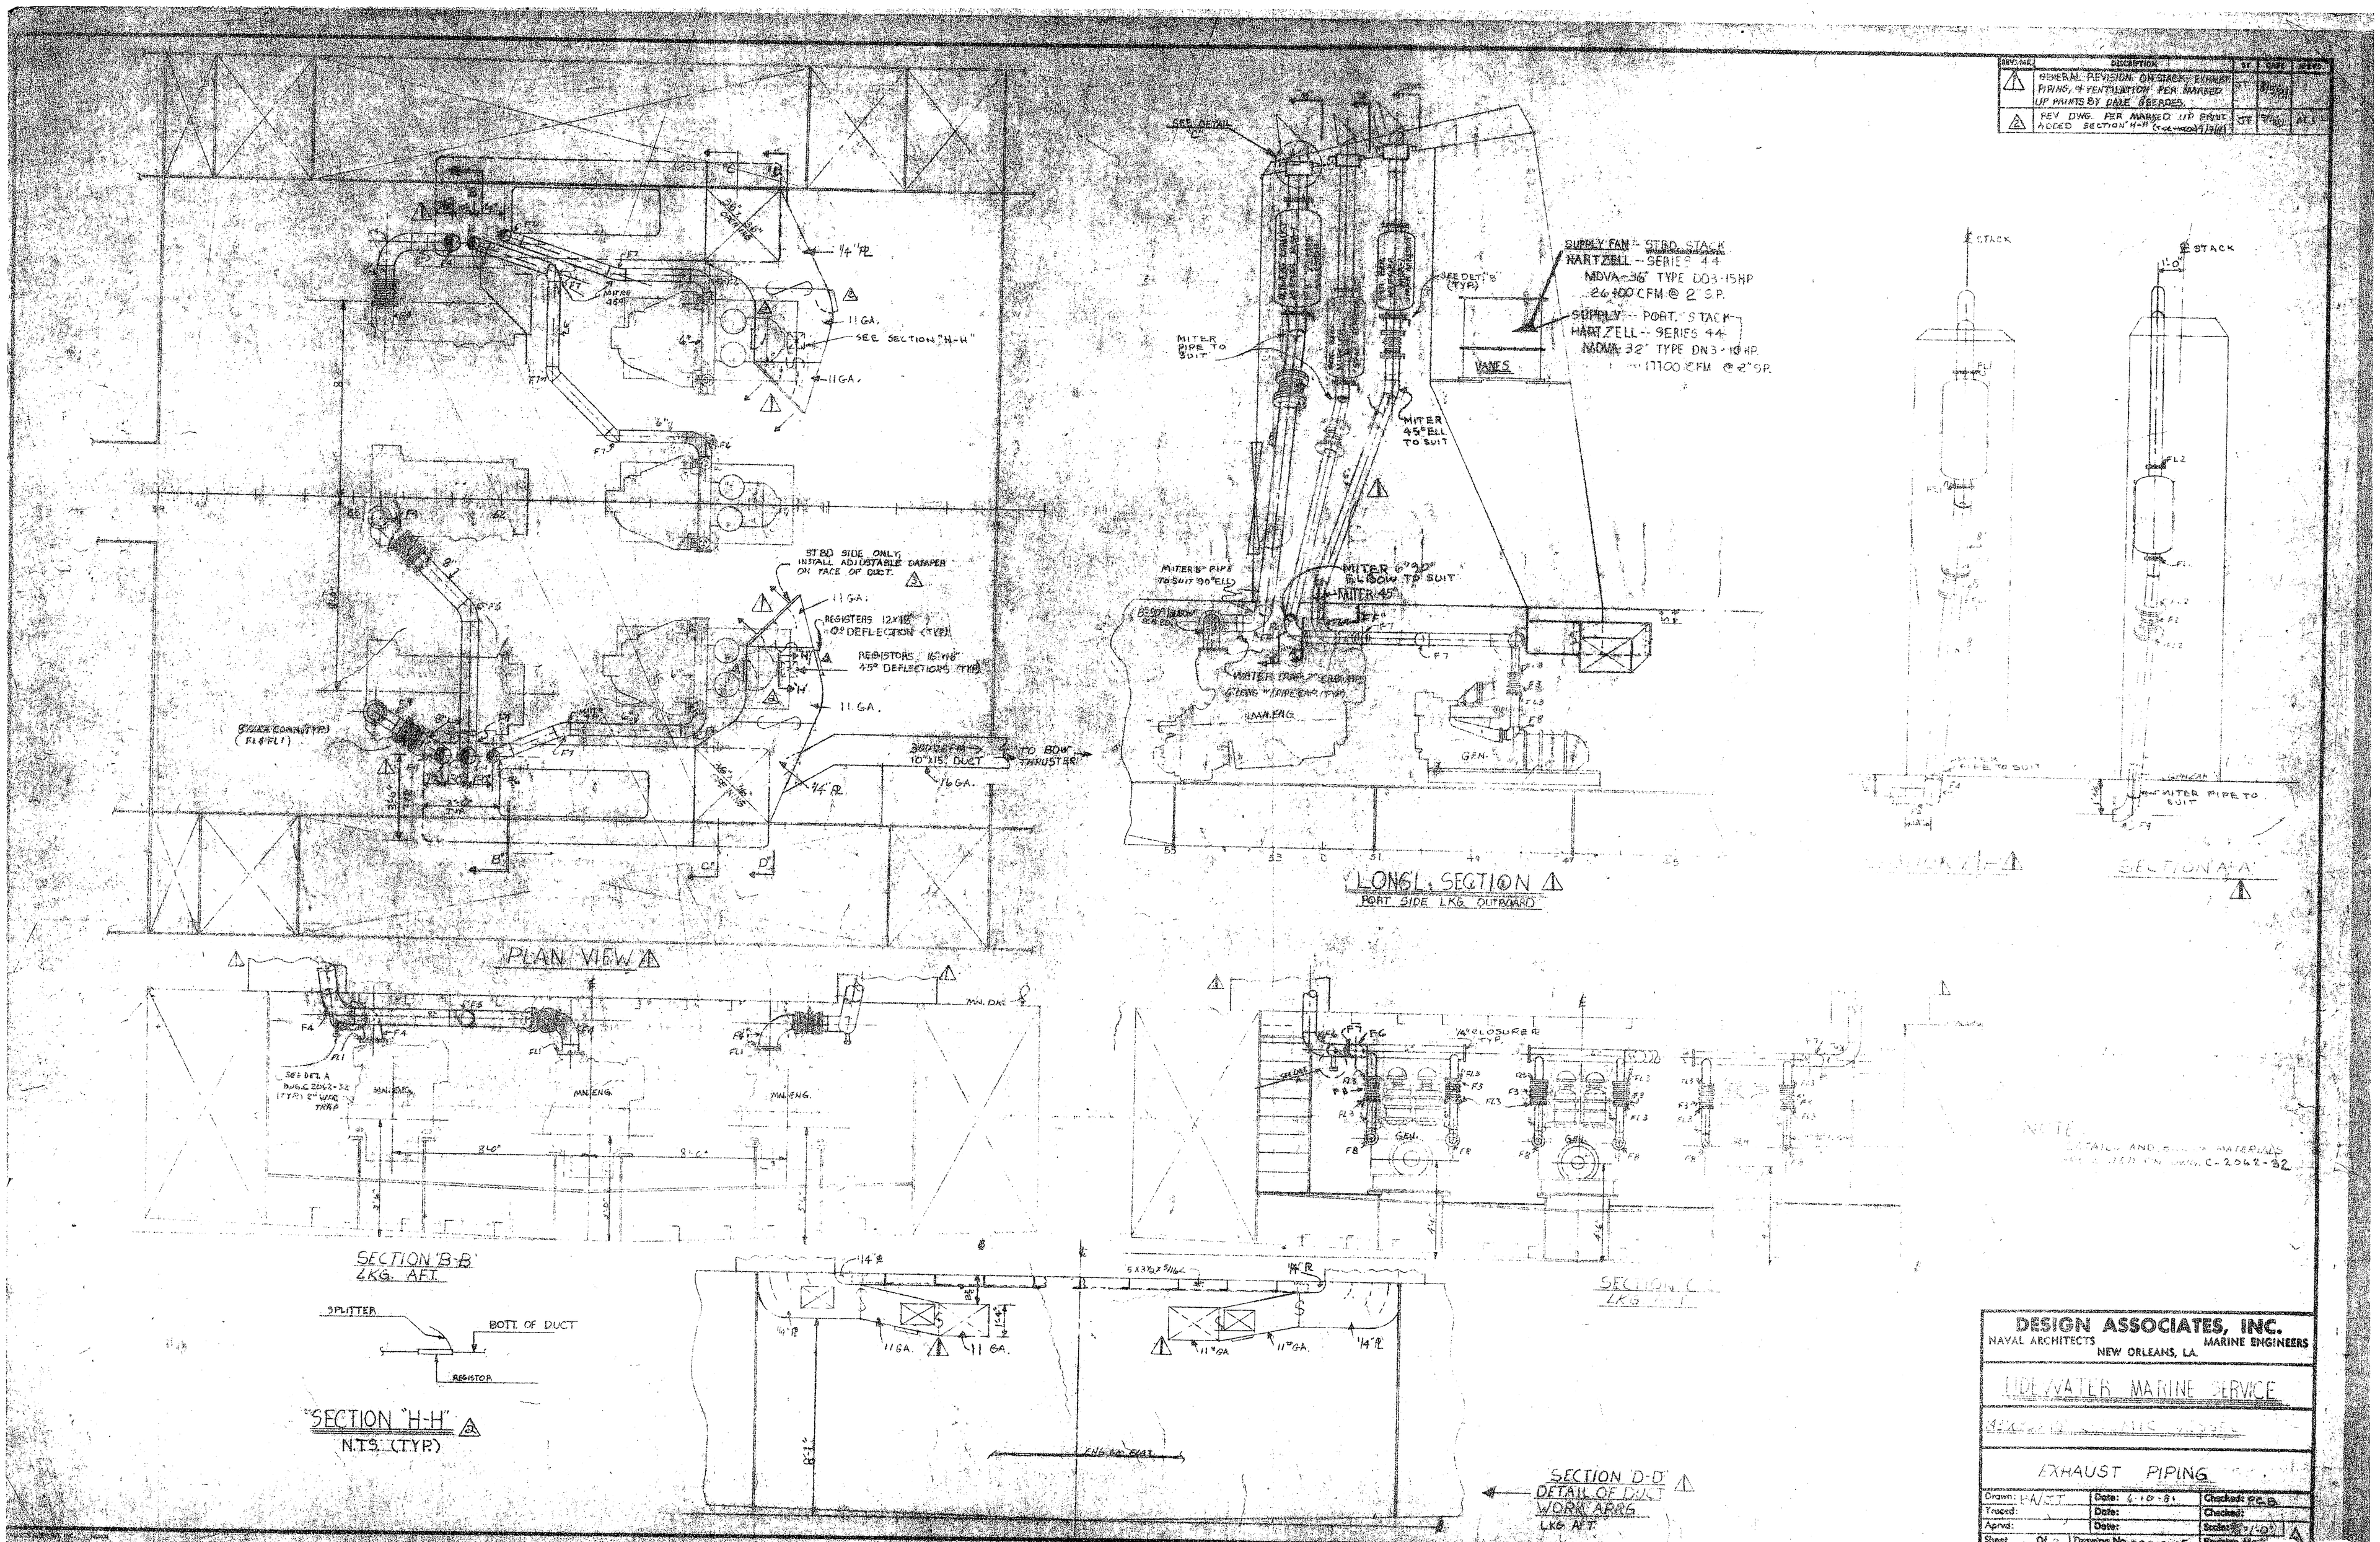

REV. NO. | DESCRIPTION | BY | DATE | APPD.
1 | GENERAL REVISION ON STACK, EXHAUST PIPING, & VENTILATION PER MARKED UP PRINTS BY DALE GEERDES. | JT | 8/5/81
2 | REV DWG. PER MARKED UP PRINT ADDED SECTION "H-H" | JT | 9/1/81 | ALS
PLAN VIEW
LONGL. SECTION
PORT SIDE LKG. OUTBOARD
SECTION "A-A"
SECTION "B-B"
LKG. AFT.
SECTION "C-C"
SECTION "D-D"
DETAIL OF DUCT WORK ARRG.
LKG. AFT.
SECTION "H-H"
N.T.S. (TYP.)
SPLITTER
BOTT. OF DUCT
REGISTOR
SUPPLY FAN - STBD. STACK
HARTZELL - SERIES 44
MDVA-36" TYPE DD3-15HP
26,400 CFM @ 2" S.P.
SUPPLY - PORT. STACK
HARTZELL - SERIES 44
MDVA-32" TYPE DN3-10HP
17700 CFM @ 2" S.P.
VANES
MITER PIPE TO SUIT
MITER 45° ELL TO SUIT
MITER 6"90° ELBOW TO SUIT
MITER 45°
STBD SIDE ONLY, INSTALL ADJUSTABLE DAMPER ON FACE OF DUCT.
REGISTERS 12"x18" 0° DEFLECTION (TYP.)
REGISTORS 16"x18" 45° DEFLECTIONS (TYP.)
TO BOW THRUSTER
11 GA.
16 GA.
1/4" PL.
SEE SECTION "H-H"
SEE DETAIL "C"
SEE DET. "B" (TYP.)
MITER PIPE TO SUIT
GEN.
MN. ENG.
NOTE: DETAILS AND SCHEDULE MATERIALS SPECIFIED ON DWG. C-2062-32
DESIGN ASSOCIATES, INC.
NAVAL ARCHITECTS
MARINE ENGINEERS
NEW ORLEANS, LA.
TIDEWATER MARINE SERVICE
EXHAUST PIPING
Drawn: | Date: 6-10-81 | Checked: P.C.B.
Traced: | Date: | Checked:
Aprvd: | Date: | Scale: 1/8"=1'-0"
Sheet 1 Of 2 | Drawing No. C-2062-15 | Revision No. A
GX044