REV. MK.	DESCRIPTION	BY	DATE	APRVD.
	REVISED APVD. BY ABS 8/31/81			
1	REVISED BOLTS ON GEN. FDN. PER HUGH SMITH COMMENTS 9-16-81	JRC	9/21/81	A.L.S.
2	REVISED FOUNDATIONS AS PER AS BUILT INSTALLATION.	JRC	11/10/82	

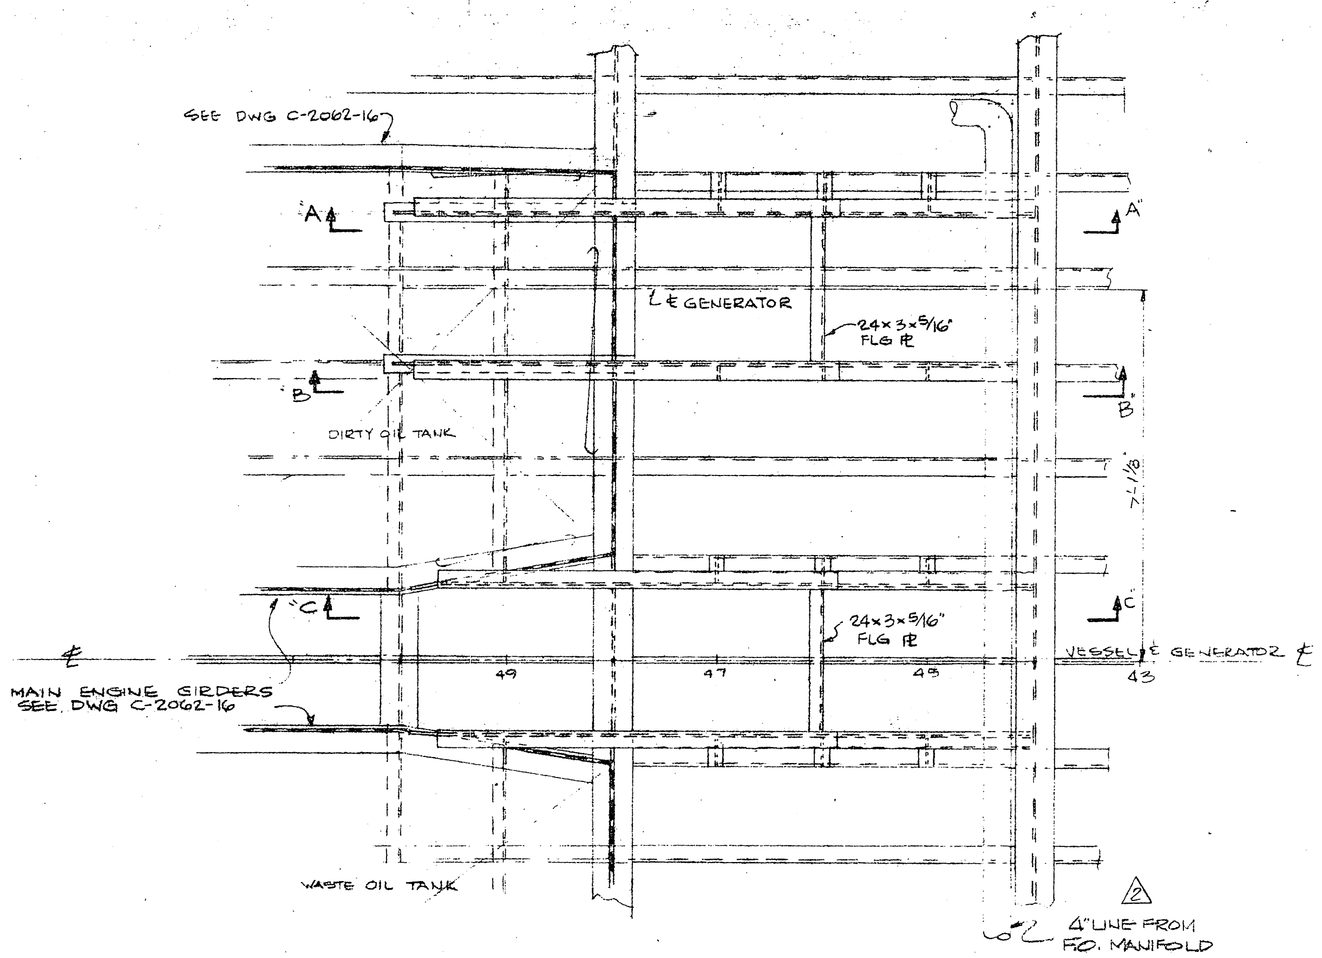

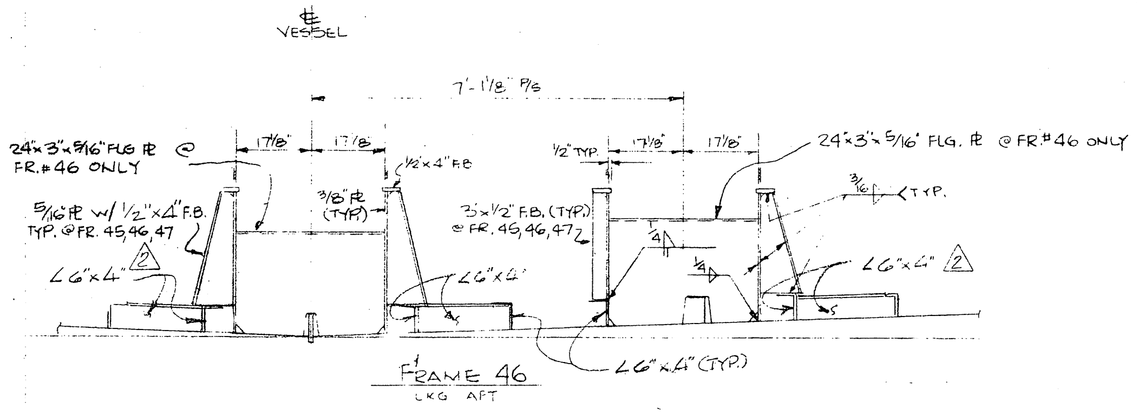

FRAME 46
LKG AFT

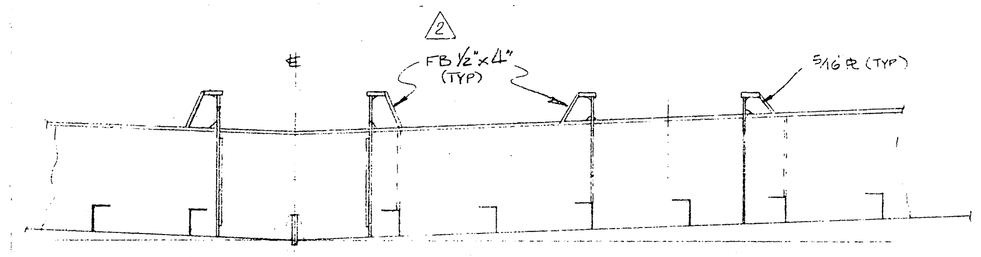

FRAME 48
LKG AFT

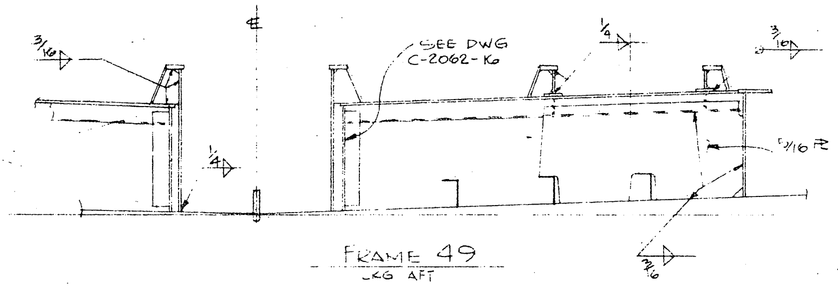

FRAME 49
LKG AFT

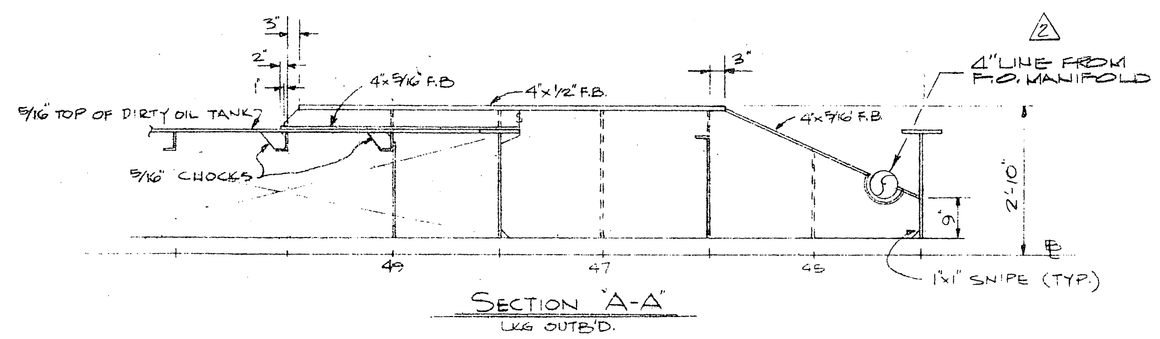

SECTION "A-A"
LKG OUTB'D.

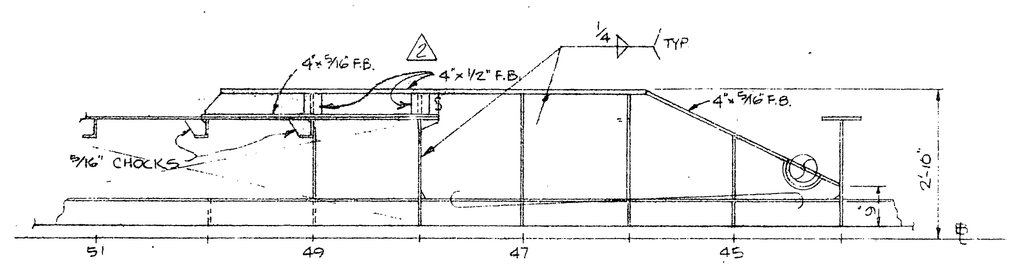

SECTION "B-B"
LKG OUTB'D.

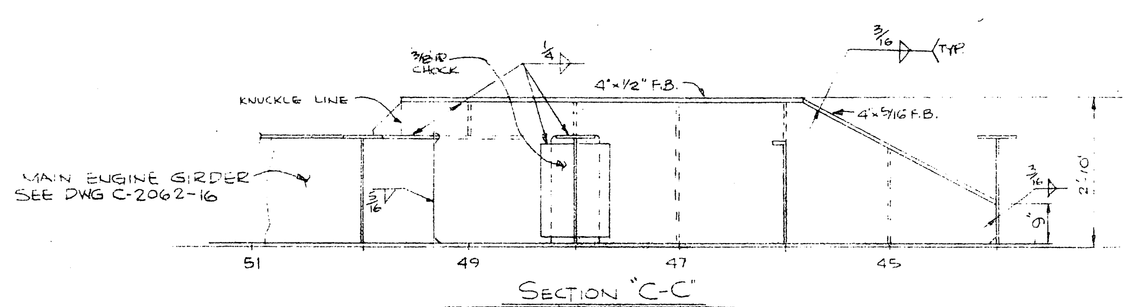

SECTION "C-C"
LKG. OUTBD.

MISSISSIPPI MARINE TOWBOAT CORP. HULL # 90

DESIGN ASSOCIATES, INC.
NAVAL ARCHITECTS MARINE ENGINEERS
NEW ORLEANS, LA.

TIDEWATER MARINE SERVICE

142'x 36'x 10' "SEISMIC" VESSEL

GENERATOR FOUNDATIONS

Drawn: J. COOK, JR	Date: 8/21/81	Checked: A.L.S.	
Traced:	Date:	Checked:	
Aprvd:	Date:	Scale: 1/2", 1'-0"	
Sheet 1 Of 1	Drawing No. C-2062-49	Revision Mark A	

MISSISSIPPI MARINE TOWBOAT CORP. HULL #90

GX055