NOTE: ALL MACHINING DIMENSIONS SHALL BE CHECKED AGAINST PRODUCTS OR CERTIFIED DRAWINGS OF THE PRODUCTS INVOLVED.

4	REVISED CLADDING TO 3/16" AND ADDED TAPER TO ART END OF STRUT BOSS PER ABS APVL. OF REV. 1 - ABS LTR. 8/31/81	9/10/81	ALS

REV. MK.	DESCRIPTION	BY	DATE	APRVD.
1	REV. DWG. PER HUGH L. SMITH MARKED UP PRINTS 4-20-81	CE B.	5/29/81	PCB
2	REV DWG PER NEW SPEC SHEET OF REDUCTION GEAR	JT	5/20/81	
3	REVISED DWG. PER OWNERS REQUEST.	M. B.	6/22/81	
4	ADDED NOTE TO COUPLING BOLT	ALS	9/10/81	

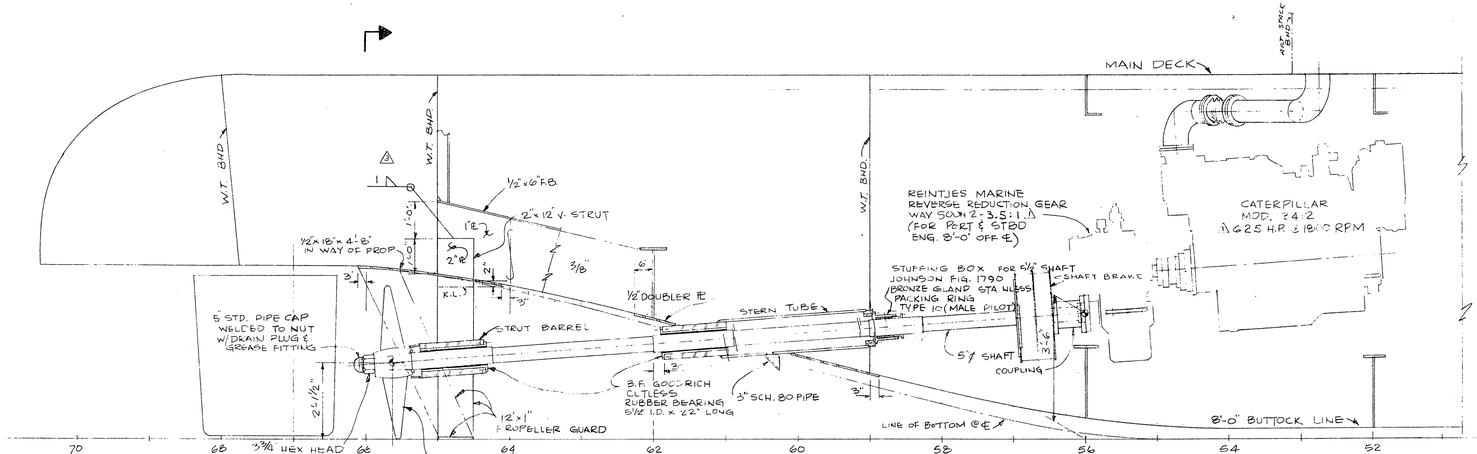

SHAFT LONGITUDINAL SECTION 8'-0" OFF ℄
SCALE: 1/2"=1'-0"

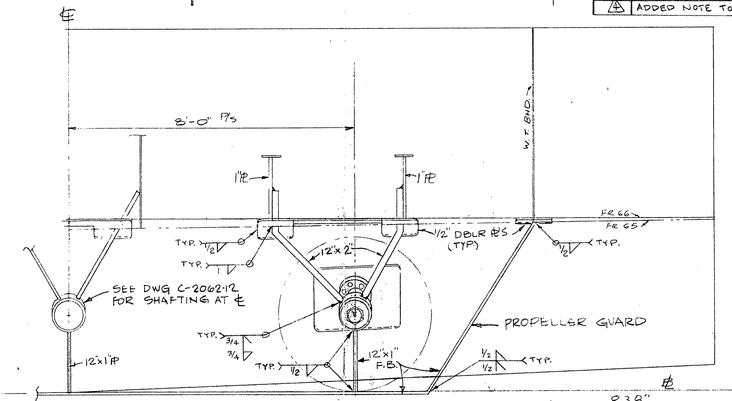

SECTION @ FR. 66 LKG. FWD.
SCALE: 1/2"=1'-0"

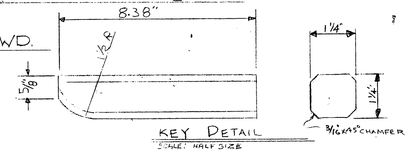

KEY DETAIL
SCALE: HALF SIZE

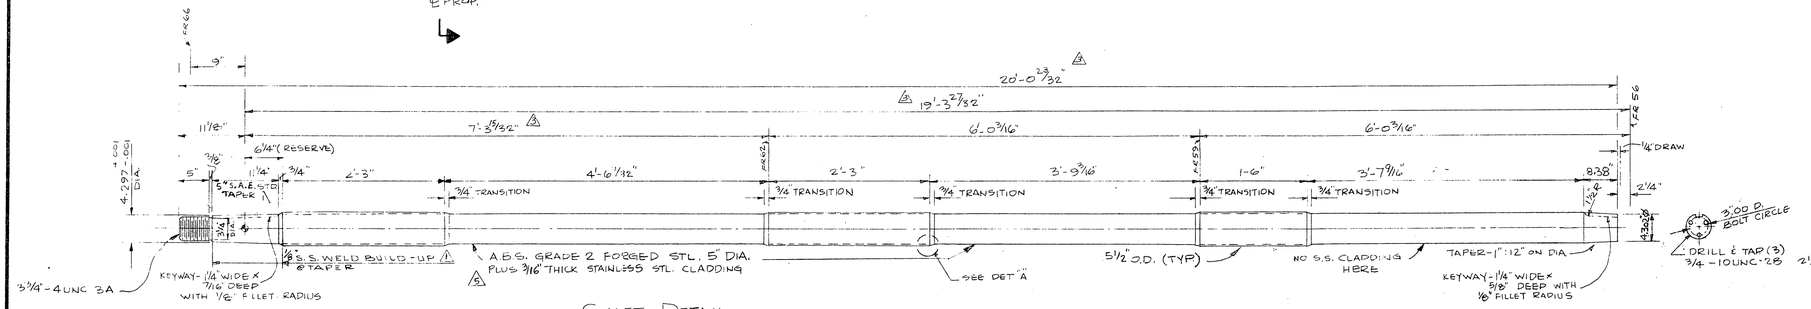

SHAFT DETAIL
SCALE: 1"=1'-0"

NOTE: SHAFT TO HAVE FOUR YEAR CERTIFICATES FROM BOTH ABS AND USCG.

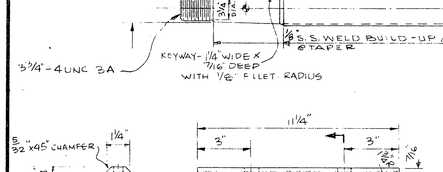

PROPELLER KEY DETAIL
SCALE: 3"=1'-0"

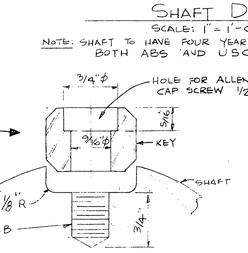

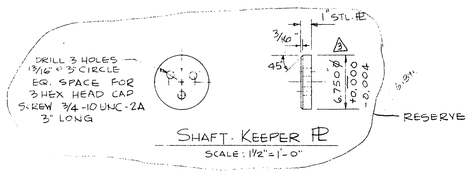

SHAFT KEEPER PL
SCALE: 1 1/2"=1'-0"

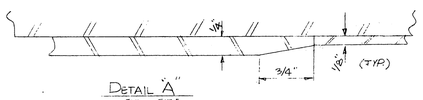

DETAIL "A"
FULL SIZE

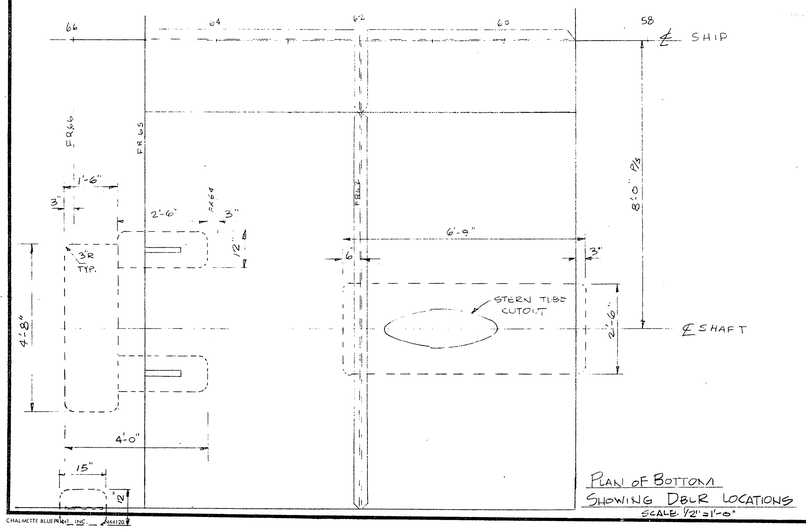

PLAN OF BOTTOM SHOWING DBLR LOCATIONS
SCALE: 1/2"=1'-0"

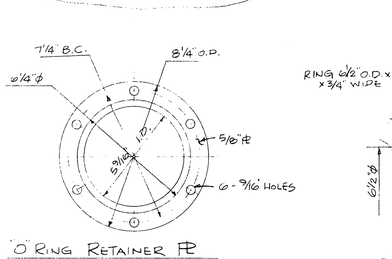

"O" RING RETAINER PL
SCALE: 3"=1'-0"

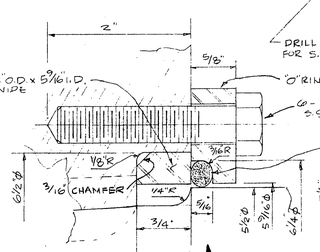

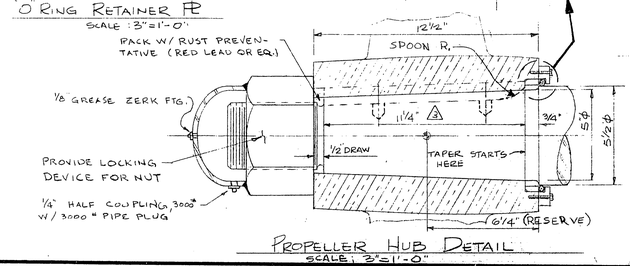

PROPELLER HUB DETAIL
SCALE: 3"=1'-0"

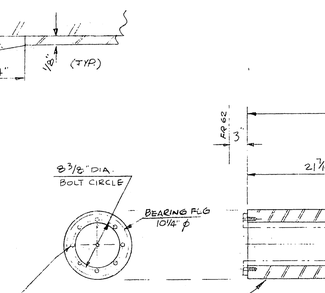

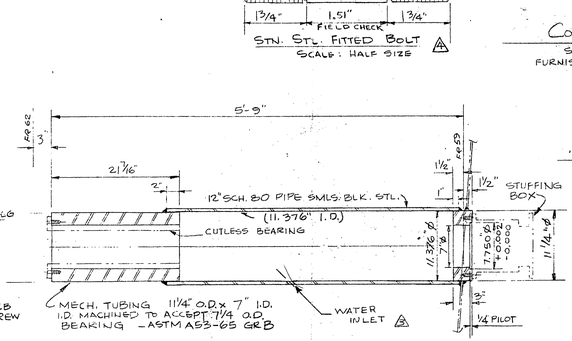

STERN TUBE
SCALE: 1"=1'-0"

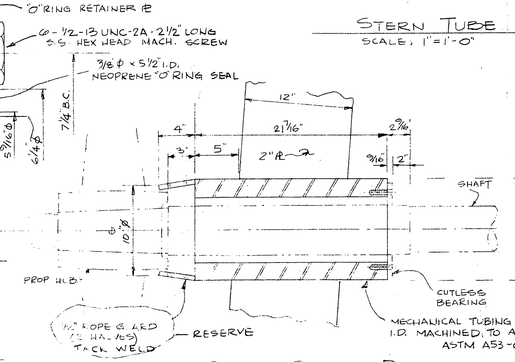

STRUT BARREL DETAIL
SCALE: 1 1/2"=1'-0"

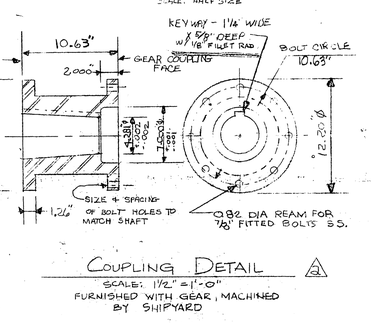

COUPLING DETAIL 2
SCALE: 1 1/2"=1'-0"
FURNISHED WITH GEAR, MACHINED BY SHIPYARD

STN. STL. FITTED BOLT
SCALE: HALF SIZE

CONSTRUCT
MISS. MARINE TOWBOAT CORP HULL # 90

DESIGN ASSOCIATES, INC.
NAVAL ARCHITECTS MARINE ENGINEERS
NEW ORLEANS, LA.

TIDEWATER MARINE SERVICE

143'x 36'x 10' SEISMIC VESSEL

OUTBOARD SHAFT ARRANGEMENT

Drawn: J. COOK JR.	Date: 3-5-81	Checked:
Traced:	Date:	Checked:
Aprvd:	Date:	Scale: AS NOTED
Sheet 1 Of 1	Drawing No. C-2062-10	4

CHALMETTE BLUEPRINT, INC. 4444120

GX087