
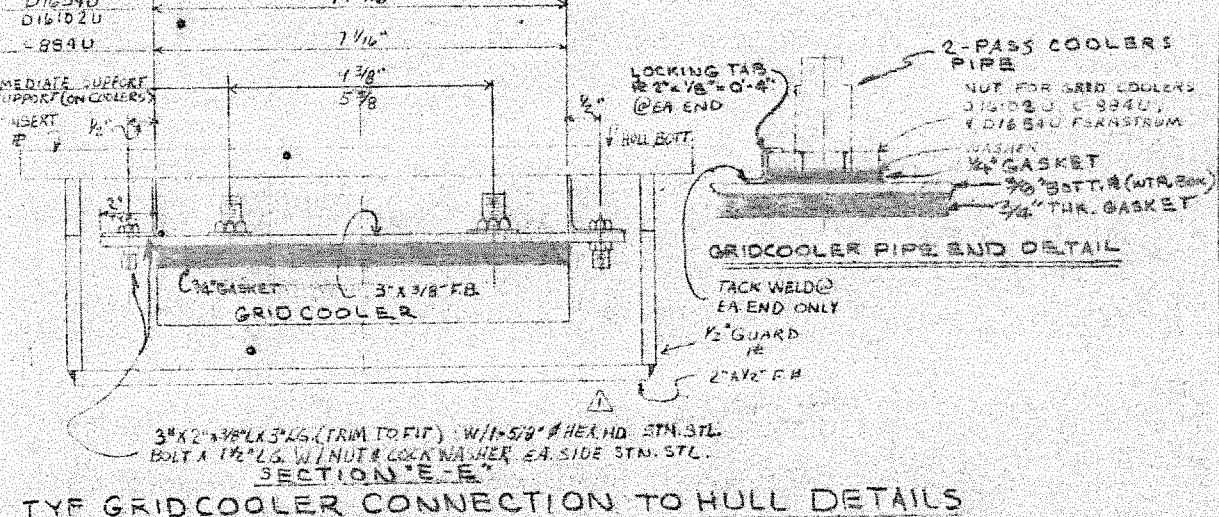
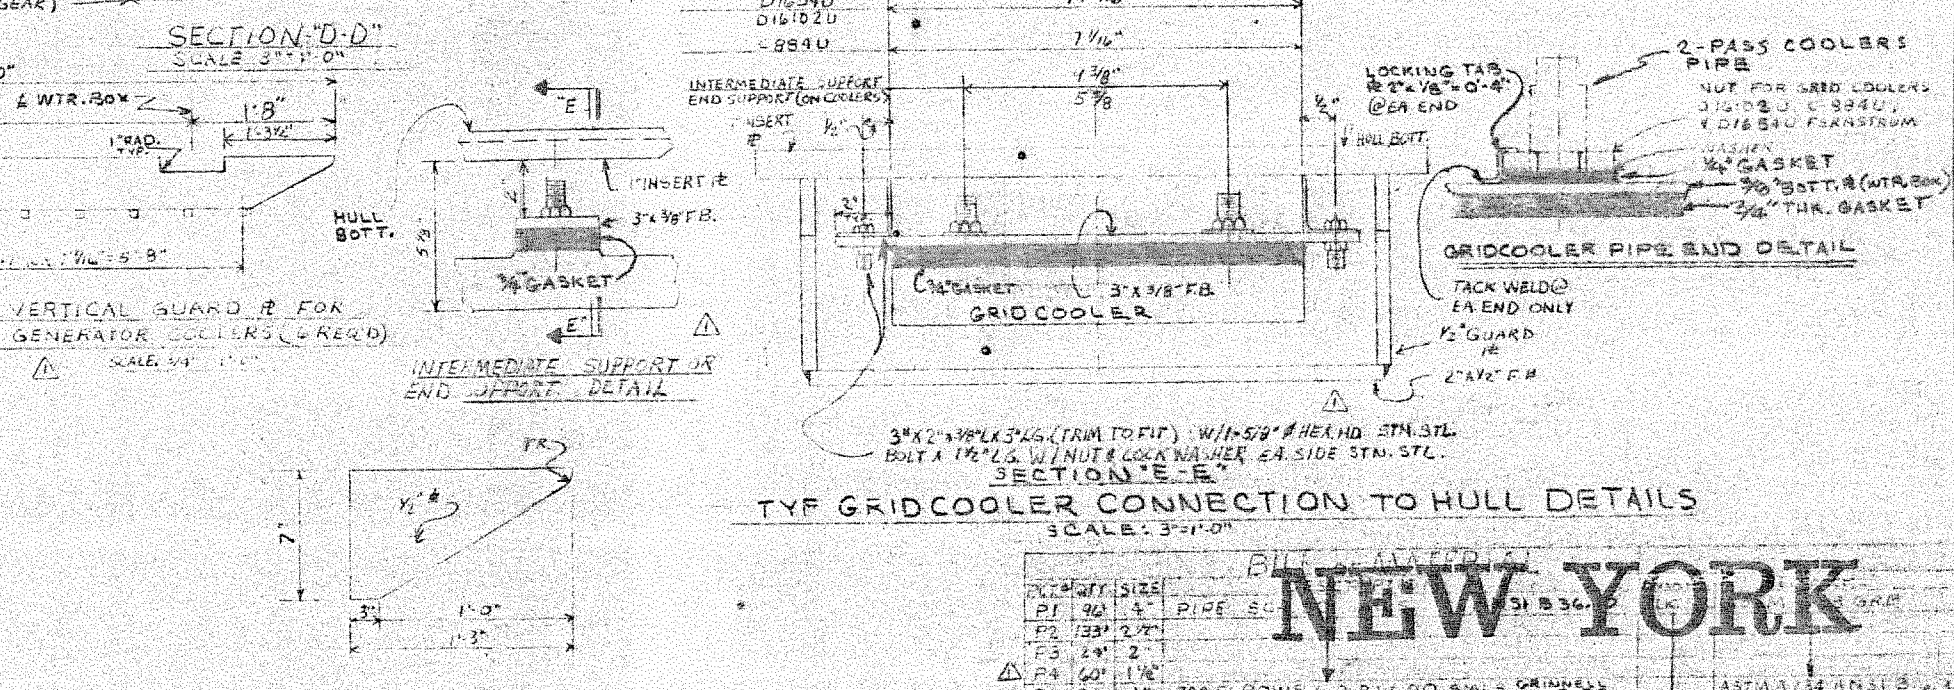
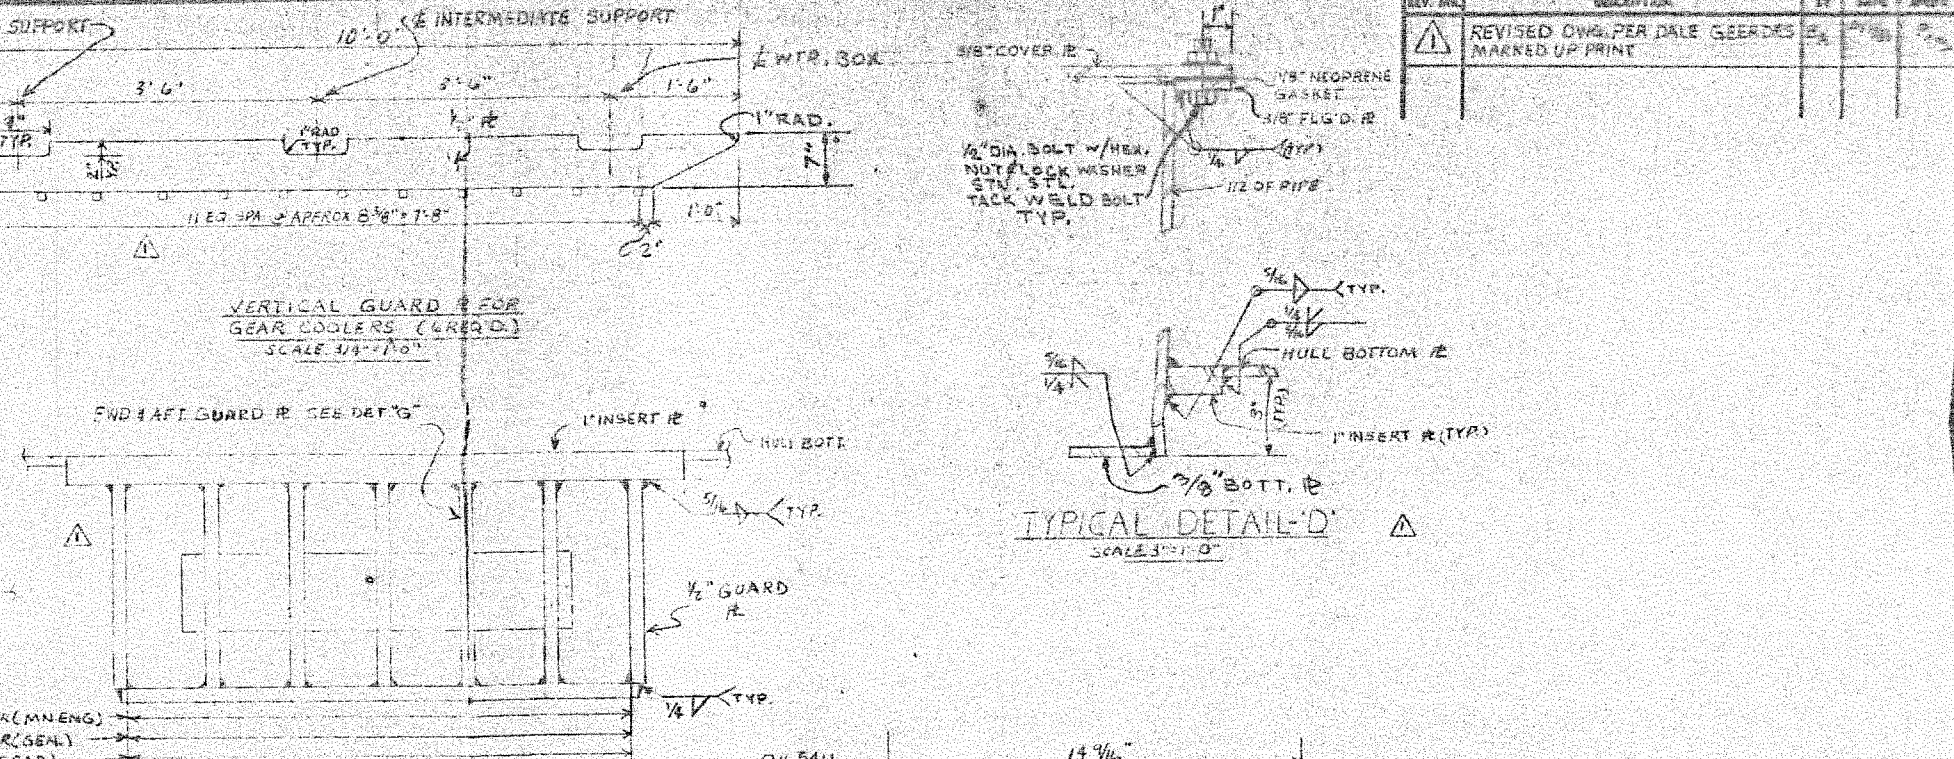
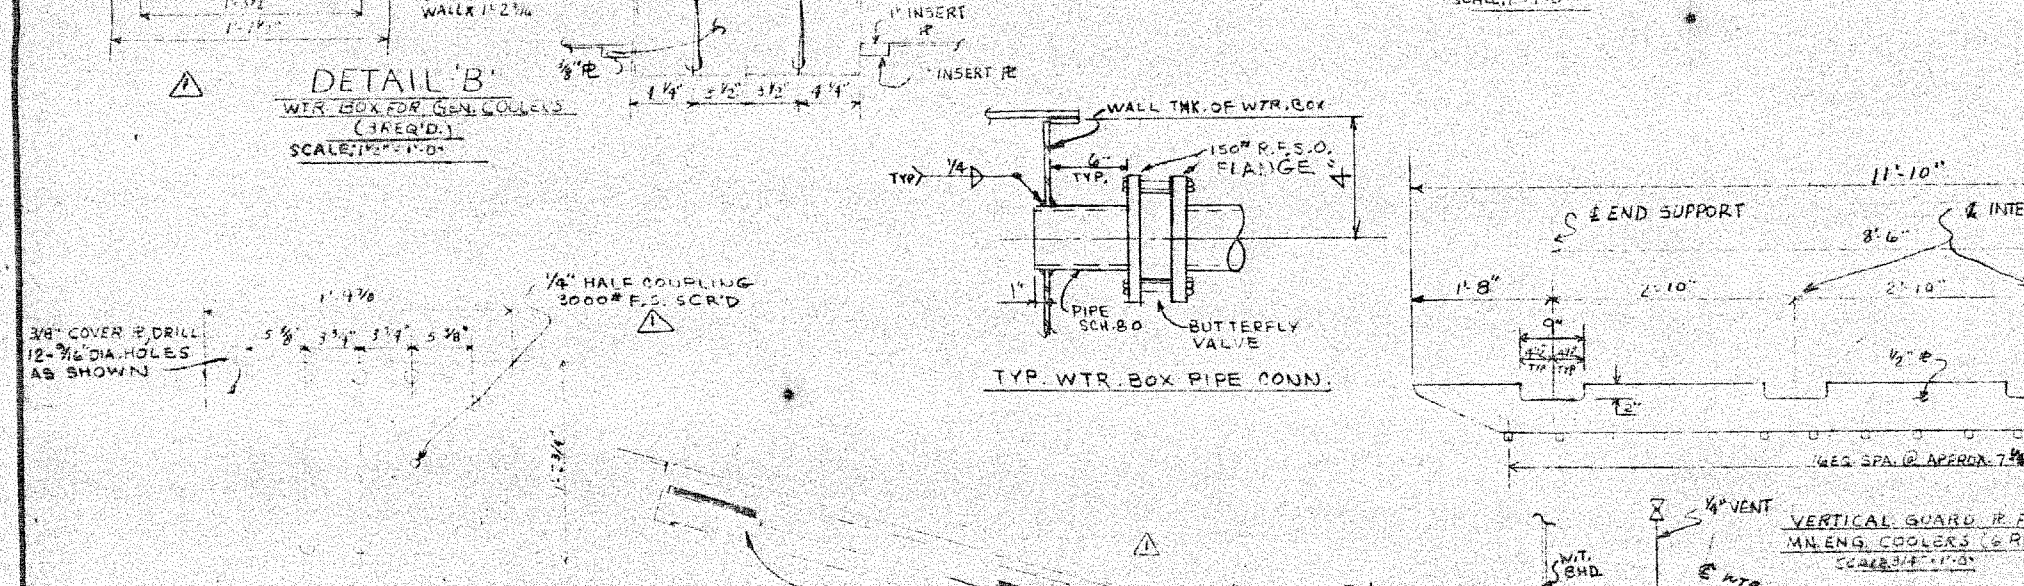
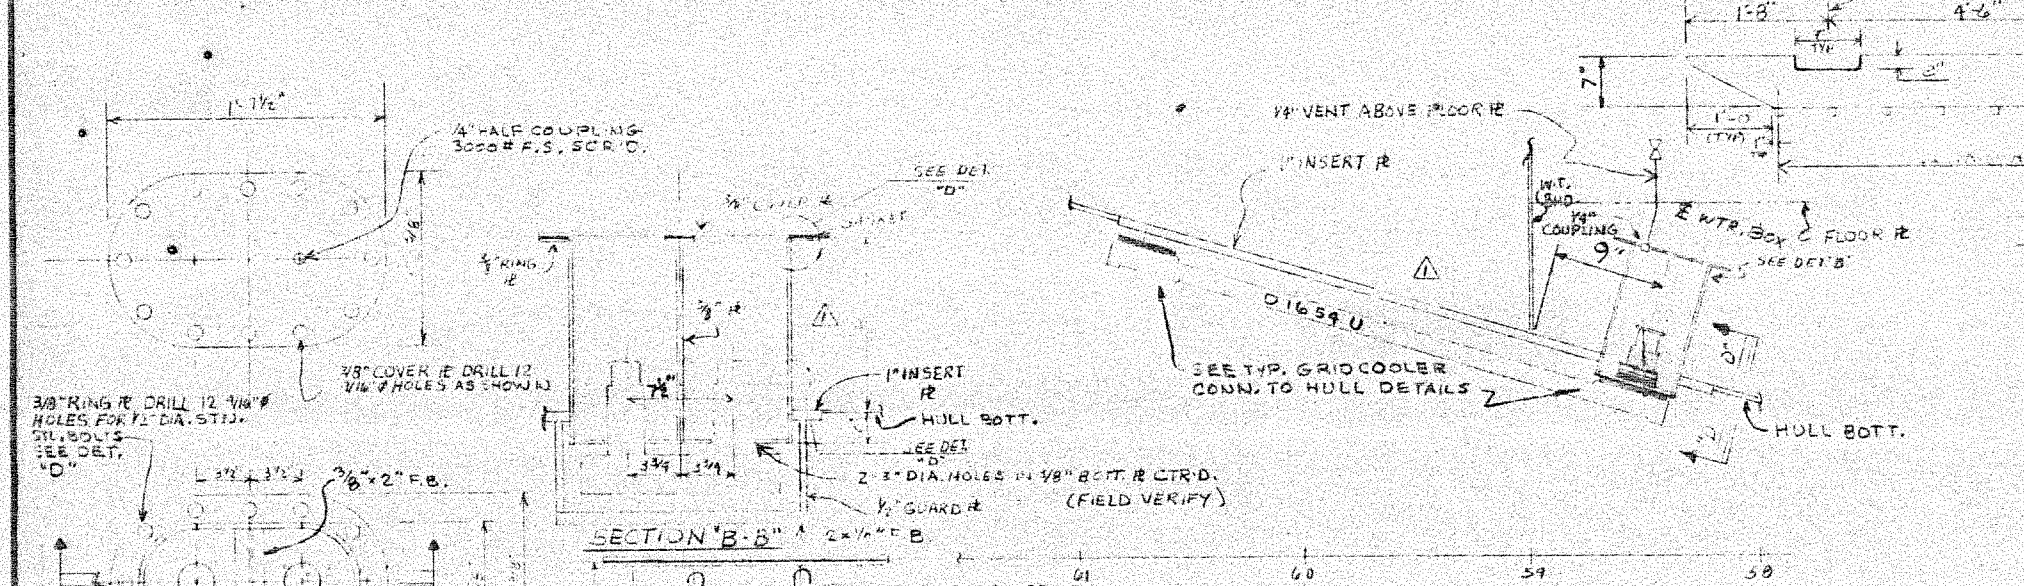
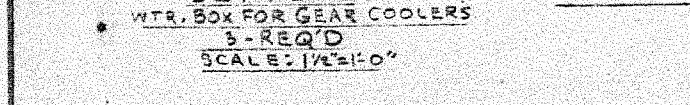


REV. NO.	DESCRIPTION	BY	DATE
1	REVISED DWG. PER DALE GEARDS MARKED UP PRINT	DA	10/1/81

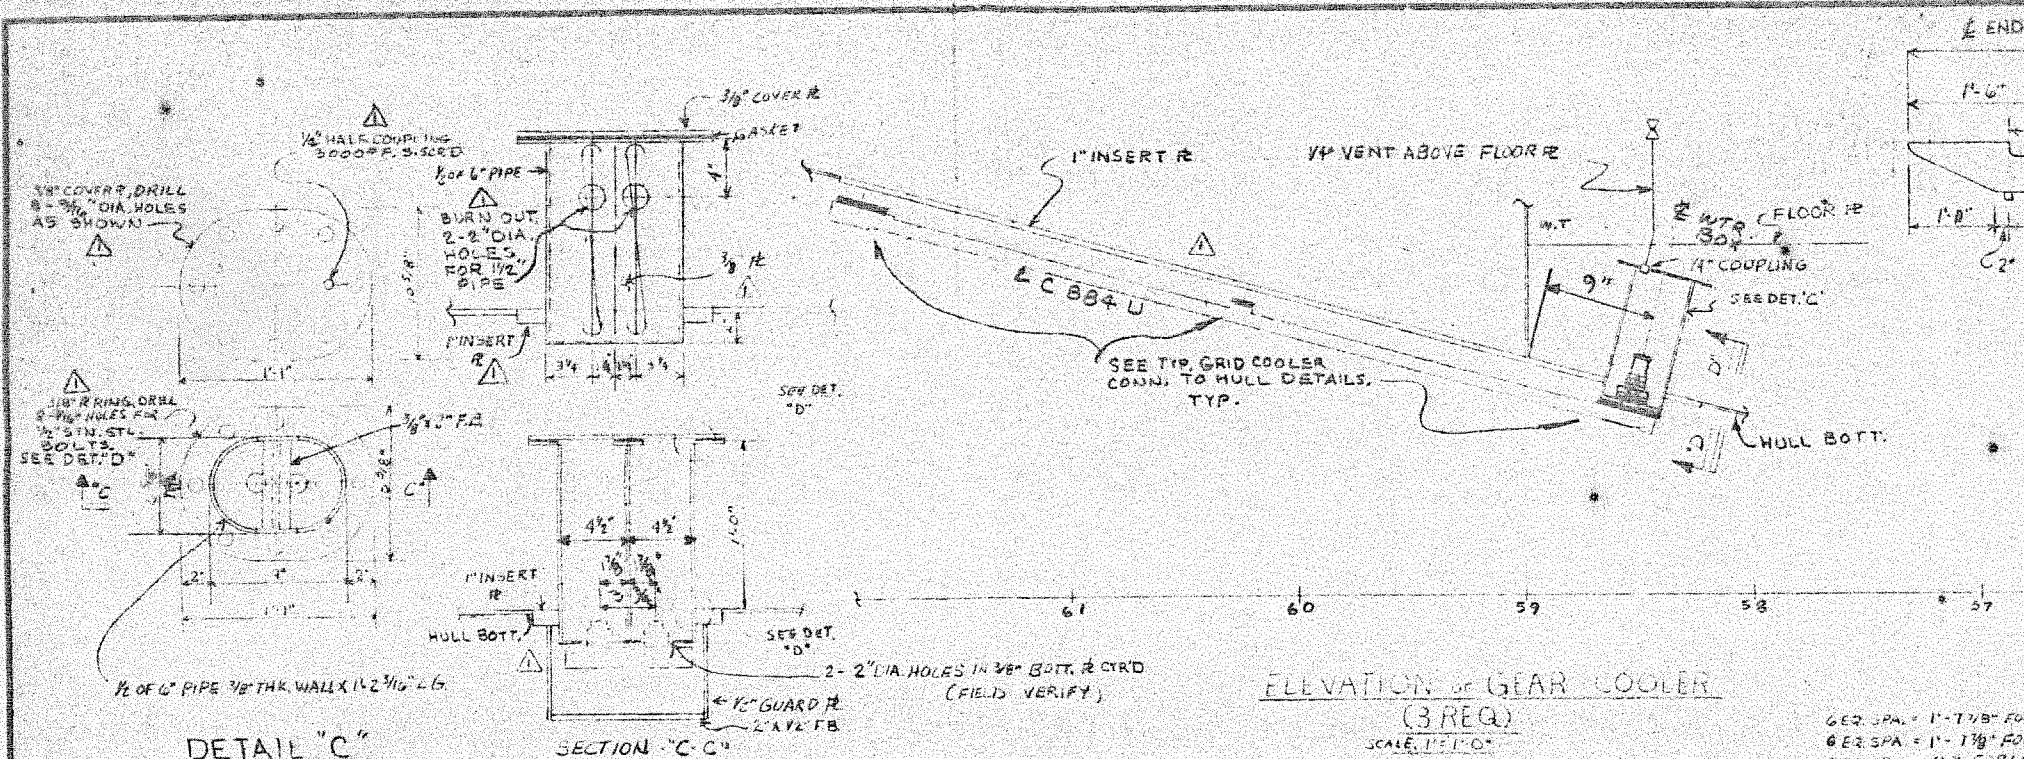

**APPROVED**  
Subject to comments in COGDS (IMM) letter of  
OCT 14 1981

**DESIGN ASSOCIATES, INC.**  
NAVAL ARCHITECTS  
MARINE ENGINEERS  
NEW ORLEANS, LA.

**TIDEWATER MARINE SERVICE**  
143' X 36' X 10' SEISMIC VESSEL

**GRID COOLER DETAILS & SECTION**

Drawn: PRT	Date: 11/3/81	Checked: PCB
Traced: [ ]	Date: [ ]	Checked: [ ]
App'd: [ ]	Date: [ ]	Checked: [ ]
Sheet: 1 of 1	Drawing No.: 2062-18	Revision: [ ]