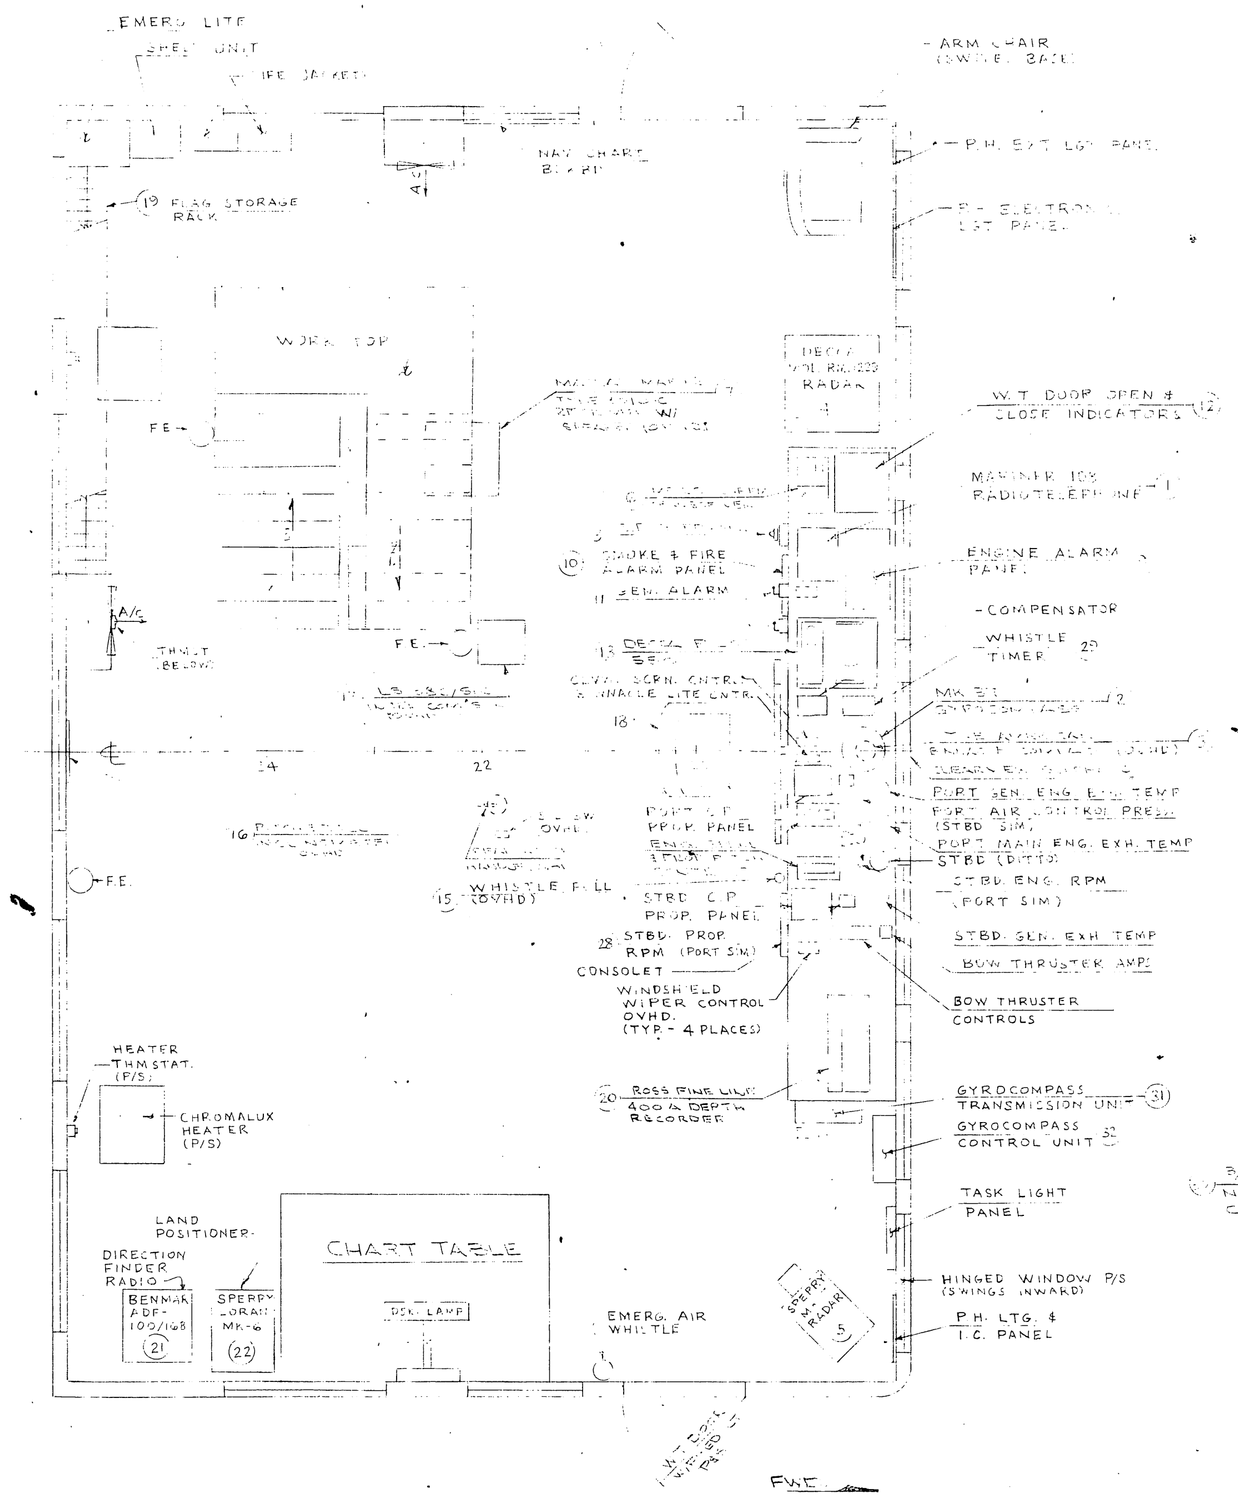

PLAN - PILOT HOUSE

1/2" = 1'-0"

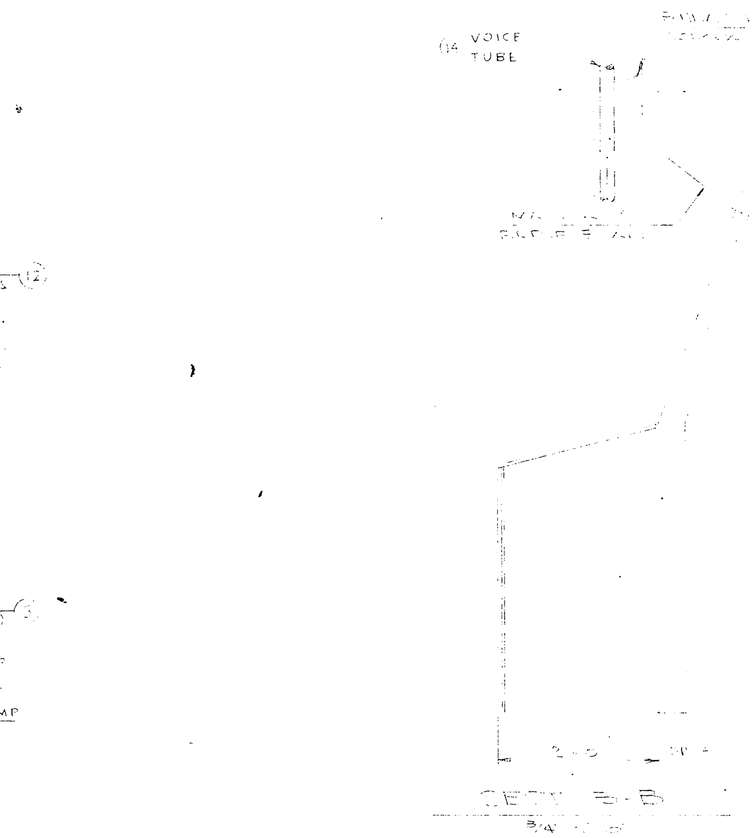

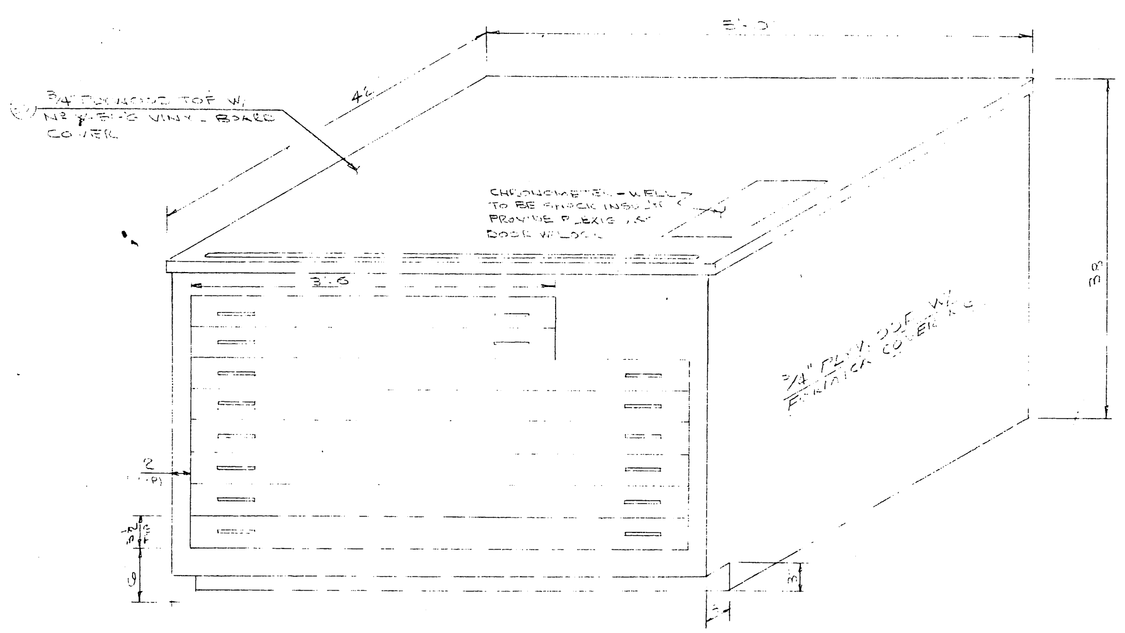

CHART TABLE

1" = 1'-0"

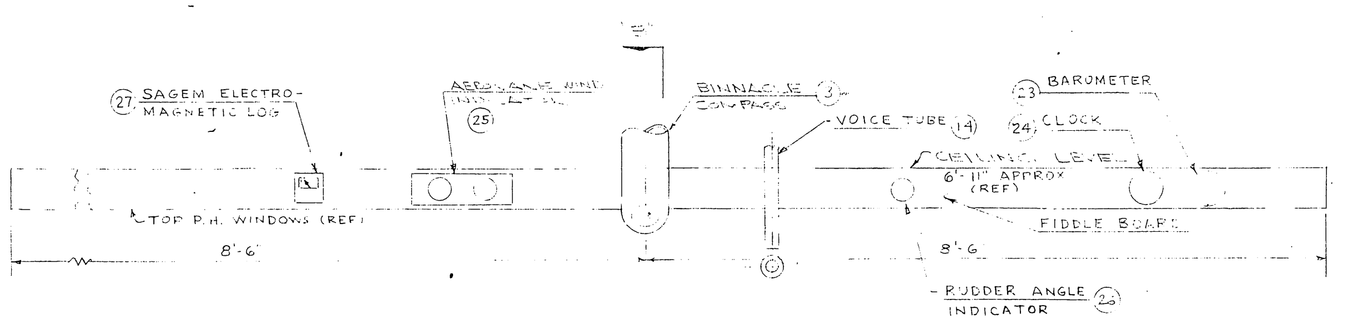

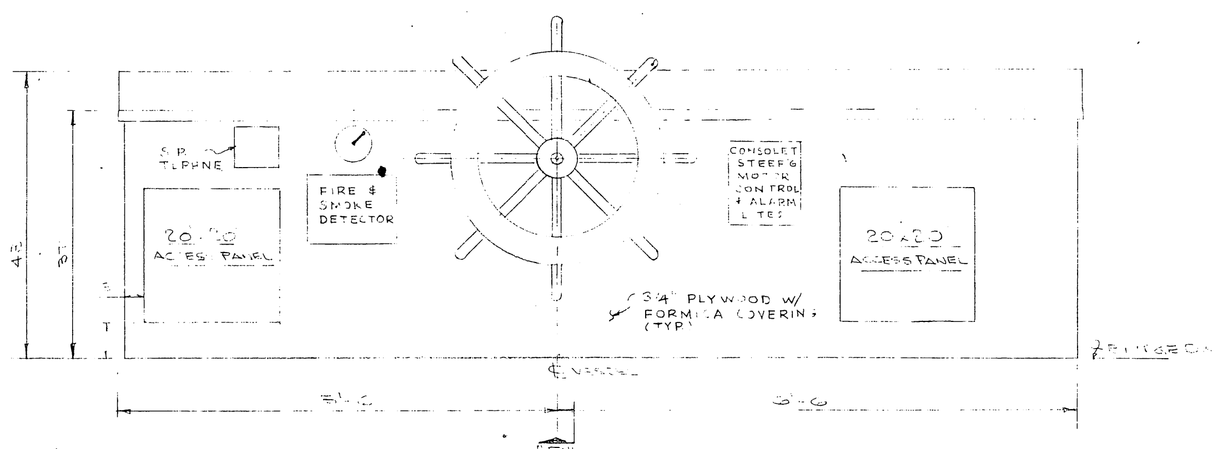

PILOT HOUSE CONSOLE & FIDDLE BD.

1/2" = 1'-0"

BILL OF MATERIALS

ITEM NO.	QUAL.	SIZE	DESCRIPTION	CATALOG ITEM	P.C. NO.	VENDOR	DATE REQ'D YARD	DATE RECD
8	1		[illegible]	436				
9	1		[illegible]	427				
10	1		[illegible] TYPE	427.1				
11	1		[illegible]	430				
12	1		[illegible]	427.1				
13	1		[illegible]	440				
14	1		[illegible]	460				
15	1		[illegible]	432				
16	1		[illegible]	460				
17	1		[illegible]	460				
18	1		[illegible]	460				
19	1		[illegible]	460				
20	1		[illegible]	460				
21	1		[illegible]	445				
22	1		[illegible]	444				
23	1		[illegible]	444				
24	1		[illegible]	460				
25	1		[illegible]	460				
26	1		[illegible]	445				
27	1		[illegible]	447				
28	1		[illegible]	444				
29	1		[illegible]	447.1				
30	1		[illegible]	452				
31	1		GYROCOMPASS TRANSMISSION UNIT	445				
32	1		GYROCOMPASS CONTROL UNIT	445				

NOV 19 1973

SYM	DESCRIPTION	DATE	BY
	REVISIONS		
1	AS BUILT	11-13-73	CJR
NO ⚠ 5-2-73			

APPROVALS

ABS _____ FCC _____

USCG _____

USPHS _____

U.S. NAVAL SHIP SYSTEMS COMMAND
WASHINGTON D.C. 20360

OCEANOGRAPHIC RESEARCH SHIP
AGOR (UTILITY) CLASS

HALTER MARINE SERVICES, INC.
P.O. BOX 29266 NEW ORLEANS, LA. 70129

PILOT HOUSE ARRGT.

SCALE-	NOTED	DATE	4-30-73	HALTER DWG. NO. A-6
DRAWN BY-	FERRELL OBERLE	CK'D BY	JOWERS	
HALTER HULL NO.	375-76	HALTER JOB NO.	2187-88	
NAVSHIPS NO.	AGOR 21-145-632			REV. 1

GYRE-0150