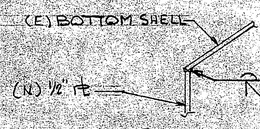

ALTERNATE
—N.T.S—

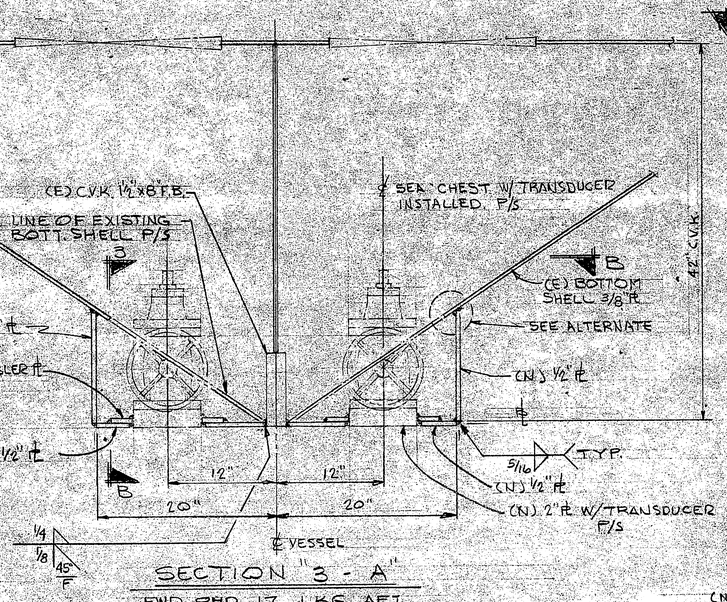

SECTION "3 - A"
FWD BHD. 17 LKG. AFT.
1 1/2" = 1'-0"

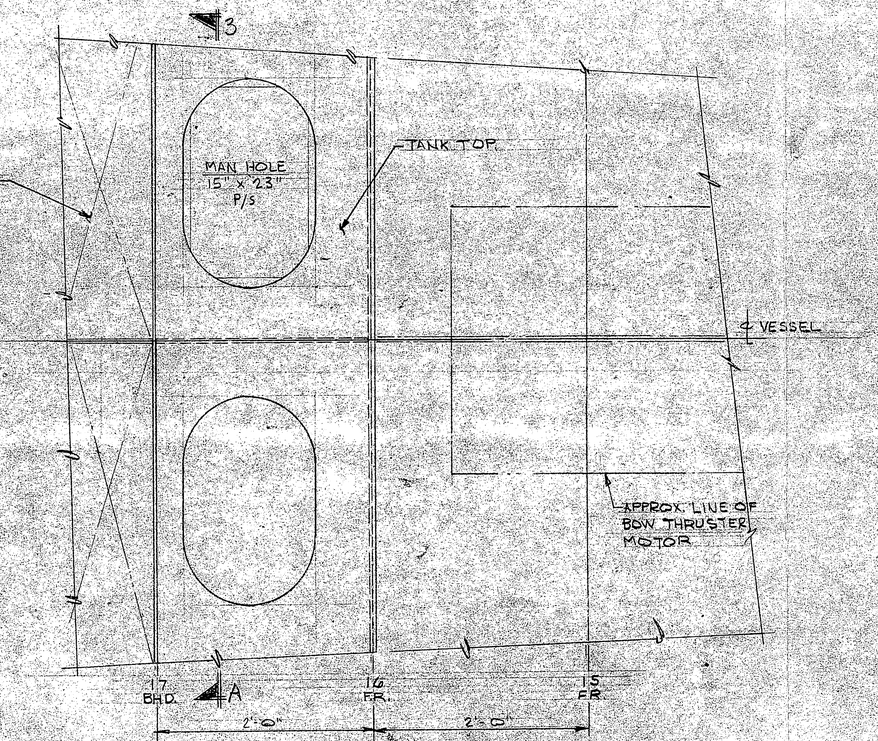

PLAN "2 - A"
PLAN @ TANK TOP
1 1/2" = 1'-0"

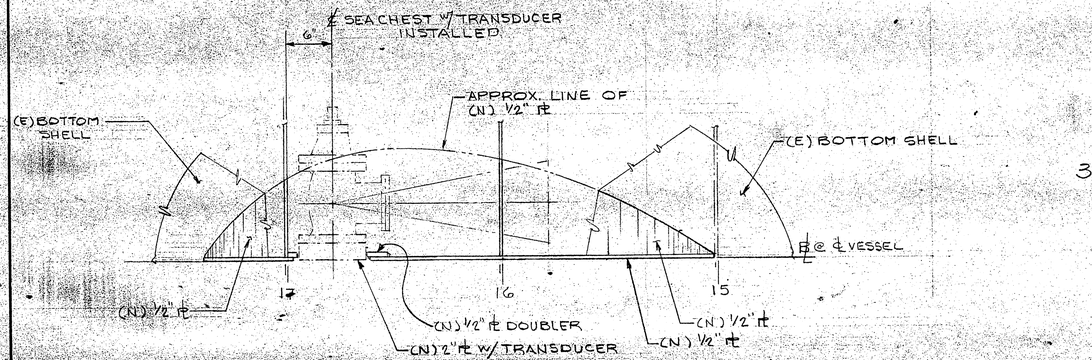

SECTION "3 - B"
STBD. LKG. IN'BD.
1 1/2" = 1'-0"

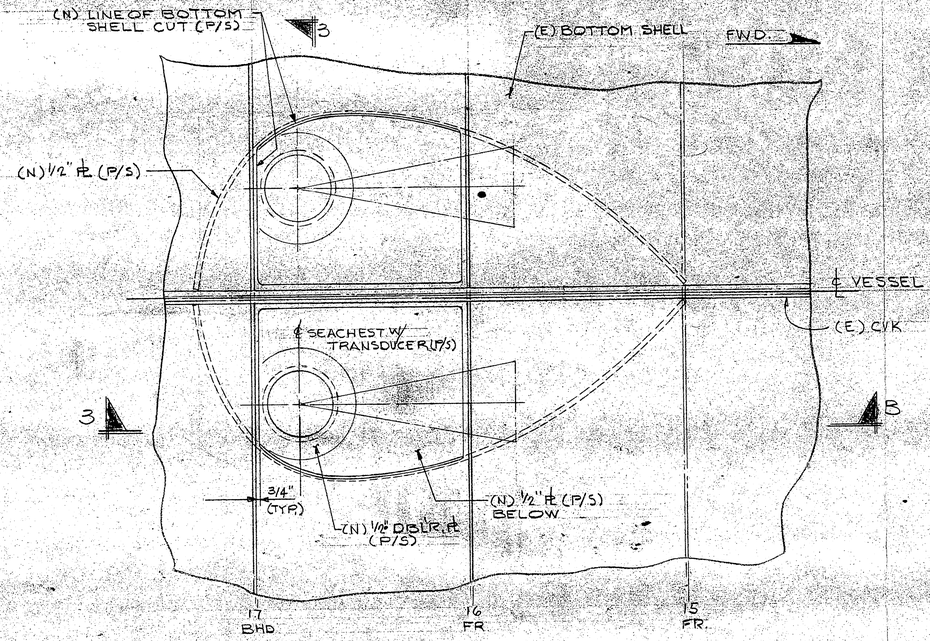

PLAN "2 - B"
PLAN @ BOTTOM SHELL
1 1/2" = 1'-0"

ALTERATIONS

MK	DESCRIPTION	DATE	APP.
1	CHANGED PER AS-BUILT SURVEY	7/1/81	BK

REFERENCES

REF.	DWG. NO.	TITLE

GENERAL NOTES

ALT.	ISSUE DATE	OWNER	ABS	CG	S&A	YARD				TOTAL
1	4/21/81	6		1						7

APPROVALS: OWNER. ABS. CG.

DISTRIBUTION

THIS DESIGN AND DRAWING ARE THE EXCLUSIVE PROPERTIES OF SCHULLER & ALLAN, INC. AND ARE FURNISHED STRICTLY ON A CONFIDENTIAL BASIS. NO PORTION OF THIS DRAWING MAY BE COPIED, TRACED, PHOTOGRAPHED, OR IN ANY OTHER WAY REPRODUCED NOR MAY ANY ITEM HEREON DEPICTED BE MANUFACTURED AS SHOWN WITHOUT THE WRITTEN CONSENT OF SCHULLER & ALLAN, INC. THE RECIPIENT OF THE INFORMATION CONTAINED HEREON MAY NOT DISCLOSE THE SAME TO ANY OTHER PERSON, NOR MAY HE USE SUCH INFORMATION EXCEPT FOR THE SPECIFIC PURPOSE INTENDED.

schuller & allan, inc.
NAVAL ARCHITECTS · MARINE ENGINEERS
HOUSTON TEXAS

DR.	CK.
RBQ.	
DATE	APP'D
4/21/81	BK

TITLE: DOPPLER INSTALLATION
BOW THRUSTER ROOM
R.V. GYRE

SCALE NOTED DWG. NO. 1888-1 ALT. 1
SHT. 1 OF 1 JOB NO.

GYRE042