BULKHEAD LABELS

INSCRIPTION	QTY.	MATL.	LTR. SIZE	LOCATION	REMARKS
W.T. BHD. FR. No. 9	1	ANODIZED ALUMINUM	½"	ON BHD. BELOW MN.DK. - AFT. SIDE -	LTRS. TO CONTRAST W/BHD.
13	2			FWD.& AFT. SIDES	
17	2			FWD.& AFT. SIDES	
22,	1				
W.T. BHD. 12" AFT. FR"26	1				
W.T. BHD. FR. No. 31	2			ON BHD. BELOW MN.DK. NEXT TO DOOR FWD.& AFT. SIDES	
38	1			ON BHD. BELOW MN. DK. - AFT. SIDE	
47	2			NEXT TO DOOR - FWD.& AFT. SIDE -	
63	2			NEXT TO DOOR - FWD.& AFT. SIDE -	
79	1			NEXT TO DOOR FWD.& AFT. SIDES	
84	1				
9	1		½"		
7	1			ON BHD. ABV. MN.DK. - FWD. SIDE -	
9	1			- AFT. SIDE -	
W.T. BHD. FR. No. 21	1		½"	- FWD.& AFT. SIDE -	

PORTABLE FIRE EXT. LABLES

INSCRIPTION	QTY.	MATL.	LTR. SIZE	LOCATION	REMARKS
No. 1 LAB - FOCSLE DK.	1	ANODIZED ALUMINUM	½"	ON EXT. & W/ 1 ON BHD. No. 30 - ABV. EXT. -	LTRS. TO CONTRAST W/EXT.
No. 2 A/C RM FOCSLE DK.				& W/ "2" ON BHD. 3'-0" OFF ℄ ABV. EXT.	
No. 3 PANTRY MN.DK.				& W/ "3" ON BHD. No. 13 - ABV. EXT.	
No. 4 PASSAGEWAY				& W/ "4" ON BHD. No. 13 ABV. EXT.	
No. 5 PASSAGEWAY				& W/ "5" ON BHD. No. 17, 2'-0" OFF ℄ ABV. EXT.	
No. 6 GALLEY				& W/ "6" ON COUNTER ABV. EXT.	
No. 7 GALLEY				& W/ "7" ON COUNTER ABV. EXT.	
No. 8 GALLEY				& W/ "8" ON BHD. No. 32 ABV. EXT.	
No. 9 GALLEY				& W/ "9" ON BHD. 1'-6" OFF ℄ ABV. EXT.	
No. 10 LOCKER MN.DK.				& W/ "10" ON BHD. IN LKR. ABV. EXT.	
No. 11 PASSAGEWAY - HOLD				& W/ "11" ON BHD. No. 25 ABV. EXT.	
No. 12				& W/ "12" ON BHD. No. 31 ABV. EXT.	
No. 13				& W/ "13" ON BHD. No. 47 6'-0" OFF ℄ - ABV. EXT.	
No. 14				& W/ "14" ON BHD. No. 47 6'-0" OFF ℄ - ABV. EXT.	
No. 15 ENG. RM.				& W/ "15" ON BHD. 47 - STBD. - ABV. EXT.	
No. 16				& W/ "16" ON BHD. 47 - PORT -	
No. 17				& W/ "17" ON BHD. No. 47 ABV. EXT.	
No. 18				& W/ "18" ON ELEC. PANEL ABV. EXT. - PORT -	
No. 19				& W/ "19" ON ELEC. PANEL ABV. EXT. - STBD. -	
No. 20 PASSAGEWAY				& W/ "20" ON BHD. No. 47 ABV. EXT.	
No. 21 PILOT HOUSE				& W/ "21" FLG. STOWAGE LKR.	
No. 22 PILOT HOUSE				& W/ "22" ON BHD. No. 26 ABV. EXT.	
△ No. 23 PILOT HOUSE				& W/ 23 ON HANDRAIL (INT.)	
△ No. 24 LAB				& W/ 24 ON BHD. ABV. EXT.	
No. 25 PASSAGEWAY				& W/ "25" ON BHD. ABV. EXT.	

MISC. LABLES

INSCRIPTION	QTY.	MATL.	LTR. SIZE	LOCATION	REMARKS
RIGHT RUDDER →	1	ANOD. AL.	1"	IN PILOT HOUSE OVER CONSOLE	LTRS. TO CONTRAST TO BKD. △
LEFT RUDDER ←	1		1"		
ASTERN STEERING NOT OVER RPM.	1		½"	ON CONSOLE IN PILOT HOUSE	LTRS. TO BE - RED -
DANGER HIGH VOLTAGE	BY OTHER			ON SW.BD. XMFR. IN PILOT HOUSE, LAB & ALL HIGH VOLTAGE LOCATIONS	DANGER - 1" LTRS. - RED - OTHERS ½" LTRS. - RED -
WAVEGUIDE - DO NOT PAINT OR STRIKE	2	ANOD. AL.	½"	AT BASE OF WAVEGUIDE	LTRS. TO CONTRAST
1151V 1Ø INTERCOM	1		¼	S"BD. STACK SIDE BRIDGE DECK.	BLACK LTRS.
115V HEATER CONT.	2			1-IN P.H. 1-IN LAB.	BLACK LTRS.

CONT.

INSCRIPTION	QTY.	MATL.	LTR. SIZE	LOCATION	REMARKS
DO NOT GO ALOFT WITHOUT PERMISSION	2	ANODIZED ALUMINUM	½"	NEXT TO LADDER ON STACK	RED LTRS.
WEAR SAFETY BELT WHEN ALOFT	2			NEXT TO LADDER ON STACK	
SAVE WATER USE JUST ENOUGH	4			IN EACH SHOWER	
CAUTION OPEN DOOR SLOWLY	4			ON ENGNIE ROOM DOORS	CAUTION 1" RED LTRS. OTHERS 1½" LTRS.
DOOR OPENS INTO PASSAGEWAY	7			ON ALL DOORS OPENING TO PASSAGE	WHITE LTRS.
DANGER KEEP CLEAR TWIN SCREW	2		2"	ON BLWK. AT FR. 80 DIRECTLY OVER PROPS	2" - RED LETTERS
- E -	19		½"	ON ALL EMERG. LTS.	RED LETTERS
GEN. ALARM	1		½"	ON CONSOLE DIRECTLY ABV. GEN. ALARM SWITCH	RED LETTERS
INFLATABLE LIFERAFT No 1 & 3 20 PERSON CAPACITY - EACH -	1			ON FOCSLE DK. BHD. OB. AT FR. 35 STBD. SIDE	1" RED LETTERS
INFLATABLE LIFERAFT No. 2 & 4 20 PERSON CAPACITY - EACH -	1			ON FOCSLE DK. BHD. OB. AT FR. 35 PORT SIDE	1" RED LETTERS
CAUTION NOISE HAZARDOUS AREA EAR PROTECTION REQ'D.	6			3 - ON ENG. RM. DOORS 2 - ON A/C RM DOORS 1 - ON HATCH TO THRUSTER	CAUTION 1" RED LTRS. OTHERS ½" RED LTRS.
WARNING STACK GAS	2			ON DOOR TO STACK, MN.DK. P/S	WARNING 1" RED LTRS. OTHERS ½" RED LTRS.
WHEN ALARM SOUNDS VACATE AT ONCE CO_2 RELEASED	2		1"	IN ENGINE ROOM & IN THRUSTER ROOM	BY VENDOR
NO SMOKING NO OPEN LIGHTS	1	SIGN BOARD	3"	PORTABLE TO BE PLACED ON BLWK. AS REQUIRED	3" - RED LTRS - ½" PLYWOOD - SEE DET-1 FOR HANGERS
EMERGENCY RELEASE	1	ANOD. AL.	½"	INSIDE OF FREEZER OVER LOCK	RED LTRS.
EMERGENCY ENGNE STOP	1		½"	ON BHD. 2'-3" OFF ℄ PORT SIDE AT FR. No	
△ WHEN ALARM SOUNDS GO TO YOUR STATION	8		½"	ON BHDS. ADJACENT TO GEN. ALARM BEL	RED LETTERS
△ DRILL PRESS	1		½"	OVER SOCKET FOR PRESS IN ENG. RM.	BLACK LTRS.
BRIDGE WING CONTROL	2		¼"	1-ON CONTROL STATION & 1-ON COVER	BLACK LTRS.
KEY LOCKER	1		¼	ON LKR. IN MASTER'S ST. RM.	BLACK LTRS
CABLE PASS THROUGH	8		¼"	ON BHD. OF LAB, UNDER PASS THROUGH	BLACK LTRS.
△ UNCONTAMINATED SALT WTR. SEA CHEST.	1		¼"	ON SEA CHEST FWD.	BLACK LTRS.

PERSONAL HAZARDS

QTY	MATL.	LOCATION	REMARKS
2		ON SILL TO STEP BELOW W.T. DOOR TO DECK LOCKER PORT & STBD	YELLOW BACKGROUND W/1" BLACK SLANTING STRIPES
1		ON SILL OF W.T. DOOR GOING INTO FOCSLE DECK HOUSE FROM MAN DECK	
2		ON BKT (FWD & AFT SIDES) ABV. STAIRES, GOING FROM FOCSLE DK. TO BRIDGE DK. P/S	
1		ON BHD. 2" FWD. OF FR. No. 28 AS STAIR PASSES THROUGH FOCSLE	
1		ON BHD. 2" FWD. OF FR. No. 28 AS STAIR PASSES THROUGH MAIN DECK. TO PASSAGE	
△ 1		HEAD KNOCKER AT MAIN DECK W.T. DOOR - TO GALLEY	

OPERATING INSTRUCTION

INSCRIPTION	QTY.	MATL.	LTR. SIZE	LOCATION	REMARKS
MN. ENGINE STARTING	2	ANODIZED ALUMINUM HEADING BODY ½ 1/8		ADJACENT TO EQUIPMENT - AIR	SEE SHEET SK-1
MN. ENGINE STOPPING	2				SK-2
GEN. ENGINE STARTING	2			ELECTRIC	SK-3
GEN. ENGINE STOPPING	2				SK-4
FIRE PUMP START-STOP	1				SK-5
EVAPORATOR START.	2				SK-6
RADAR OPRTN.	2			(2-SHEETS)	SK-7
SSB. XCVR. OPRTN.	1				SK-8 △
GYRO OPRTN.	1			(2-SHEETS)	SK-9
GEN. ENG. STARTING	1			AIR	SK-10
MN. ENG. STAIRTING	1			ELECTRIC	SK-11
EVAPORATOR SHUT DOWN	1		△		SK-12
EMER. STEER. OPRTN.					SK-13 △

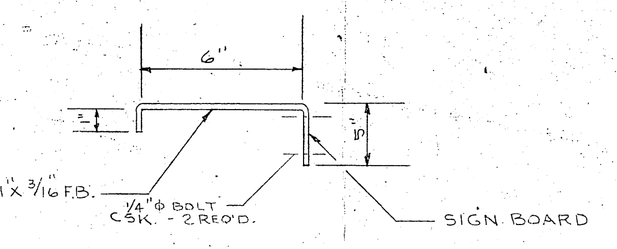

DET-1
3"= 1'-0"
- 2-REQ'D

OPERATING INSTRUCTION CONT.

INSCRIPTION	QTY.	MATL.	LTR. SIZE	LOCATION.	REMARKS
VHF - FM RADIOTELEPHONE OPERATION	1	ANOD. AL.	½" INCH 1/8 BODY	ADJACENT TO EQUIP.	SK.-14
SSB. HANDSET. OPRTN.	1				SK.-15
△ EMERGENCY INSTRUCTIONS	1			IN PASSAGEWAY UP TO PILOT HOUSE	SK.-16
△ BRIDGE WING STEER.	1			ON FRONT OF CONSOLE	SK - 17-1
△ COVER ON WING CONTROL	2			ON WING CONTROLS	SK - 18
△ DEPTH RECORDER	1			ADJACENT TO UNIT	SK-19
AUTO PILOT OPRTN.	1				SK - 20
△ TRANSCEIVER OPRTN.	1				SK - 21.

SYM	DESCRIPTION	DATE	BY
6	AS BUILT	12/5/73	GJR
5	ADDED SK 19 - 21, HEAD KNOCKERS & FIRE EXT. No 23 & 24 PER REQ.	11/7/73	GJR
4	ADDED SK-17-1 AS REQUIRED & SK-18	9/5/73	GJR
3	ADDED SK-16 AS REQUIRED	8/6/73	GJR
2	REVISED MATERAL USED FOR NAME PLATES, ADDED SK-15 AND SECOND SHEET OF SK-7 & GEN. ALARM.	8/24/73	GJR
1	REMOVED RESERVATION ON SK-7 & 9 ADDED SK. 14, 15 AND REVISED LTR. SIZE OF OPRTN. ILLUSTRATIONS.	7/2/73	GJR

REVISIONS

APPROVALS

ABS. FCC.

USCG.

USPHS.

OFFICE COPY

U.S. NAVAL SHIP SYSTEMS COMMAND
WASHINGTON D.C. 20360

OCEANOGRAPHIC RESEARCH SHIP
AGOR (UTILITY) CLASS

HALTER MARINE SERVICES, INC.
P.O. BOX 29266 NEW ORLEANS, LA. 70129

LABEL PLATES COMPTS, TANKS, BHD. & MISC

SCALE -	~	DATE	8/21/73
DRAWN BY:	Tedesco	CK'D BY	GJR
HALTER HULL NO.	375 & 376	HALTER JOB NO.	2187 & 2188
NAVSHIPS NO.	AGOR 21-605-001		

HALTER DWG. NO. M-4 PART 1 OF 11 REV. 6

SHEET 2 of 4

00026

GYRE093