


LIST OF MATERIALS

SYM#	SYM	QUAN	DESCRIPTION	MANUFACTURER	REMARKS
1	0	4	440 VAC, 25A, RECEPTACLE EREBB-416-253A	PLYE NATIONAL	REMARKS
2	0	4	440 VAC, 25A, RECEPTACLE EREBB-212-17513	PLYE NATIONAL	REMARKS
3	0	6	115 VAC, 30A, RECEPTACLE EREBB-316-253A	PLYE NATIONAL	REMARKS
4	0	11	115 VAC, 15A, RECEPTACLE NO. 2570	PAULHIN	REMARKS
5	0	1	WELDING RECEPTACLE NO. 6000	PAULHIN	REMARKS
6	0	1	RECEPTACLE EREBB-420-254-44	PLYE NATIONAL	REMARKS
7	0	2	RECEPTACLE EREBB-316-315-511	PLYE NATIONAL	REMARKS
8	0	2	RECEPTACLE EREBB-212-315-511	PLYE NATIONAL	REMARKS
9	0	4	JUNCTION BOX OR TERMINAL BOX	HOFFMAN	REMARKS
10					
11					
12					

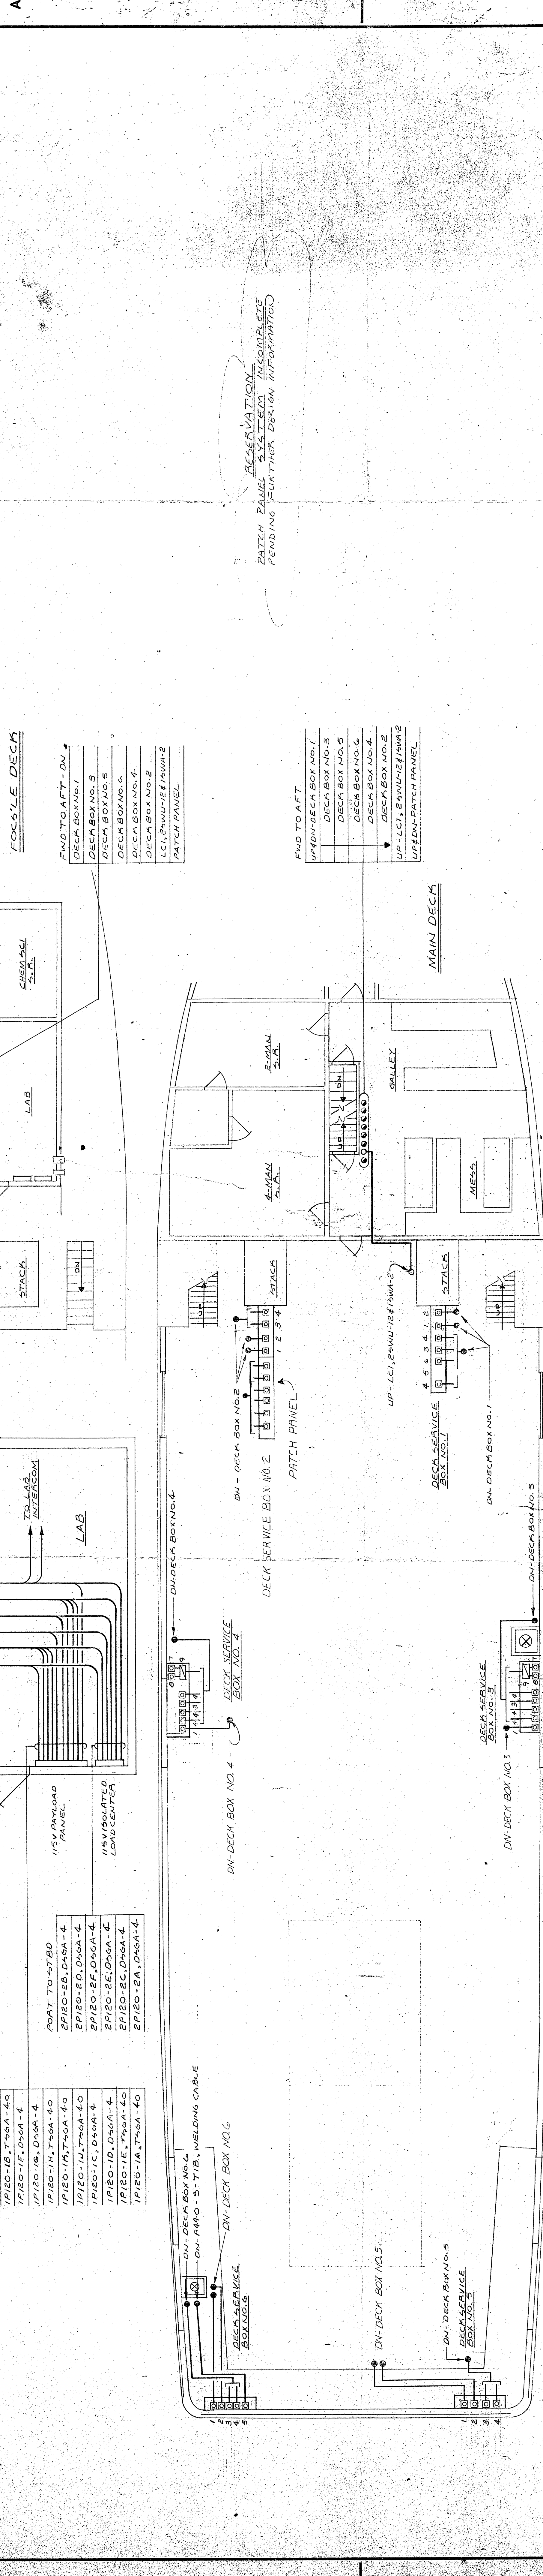

NOTES:

- ALL MATERIAL AND THE INSTALLATION THEREOF SHALL BE IN ACCORDANCE WITH U.S.C. TITLE 40, CAP. 2610 TO 2615 INCLUSIVE.
- REVISED TO SUIT "AS-BUILT" CONDITION
- MODIFIED 440V PAYLOAD PANEL FROM LAB TO ENGINE RM

APPROVALS

DATE: 10/1/54

DATE: 10/1/54

OFFICE COPY

U.S. NAVAL SHIP SYSTEMS COMMAND
WASHINGTON, D.C. 20360

OCEANOGRAPHIC RESEARCH SHIP
AGOR (UTILITY CLASS)

HALTER MARINE SERVICES, INC.
P.O. BOX 28066 NEW ORLEANS, LA. 70129


SCALE: 3/16" = 1'-0" DATE: 4-10-73 HALTER
DRAWN BY: E.D.C. CKD BY: M.Z. DWG. NO. E-12
HALTER JOB NO. 2187-2188 E-12
PULL NO. 575, 576 HALTER
NAVSHIPS NO. AGOR-21-302-401 REV. 2

