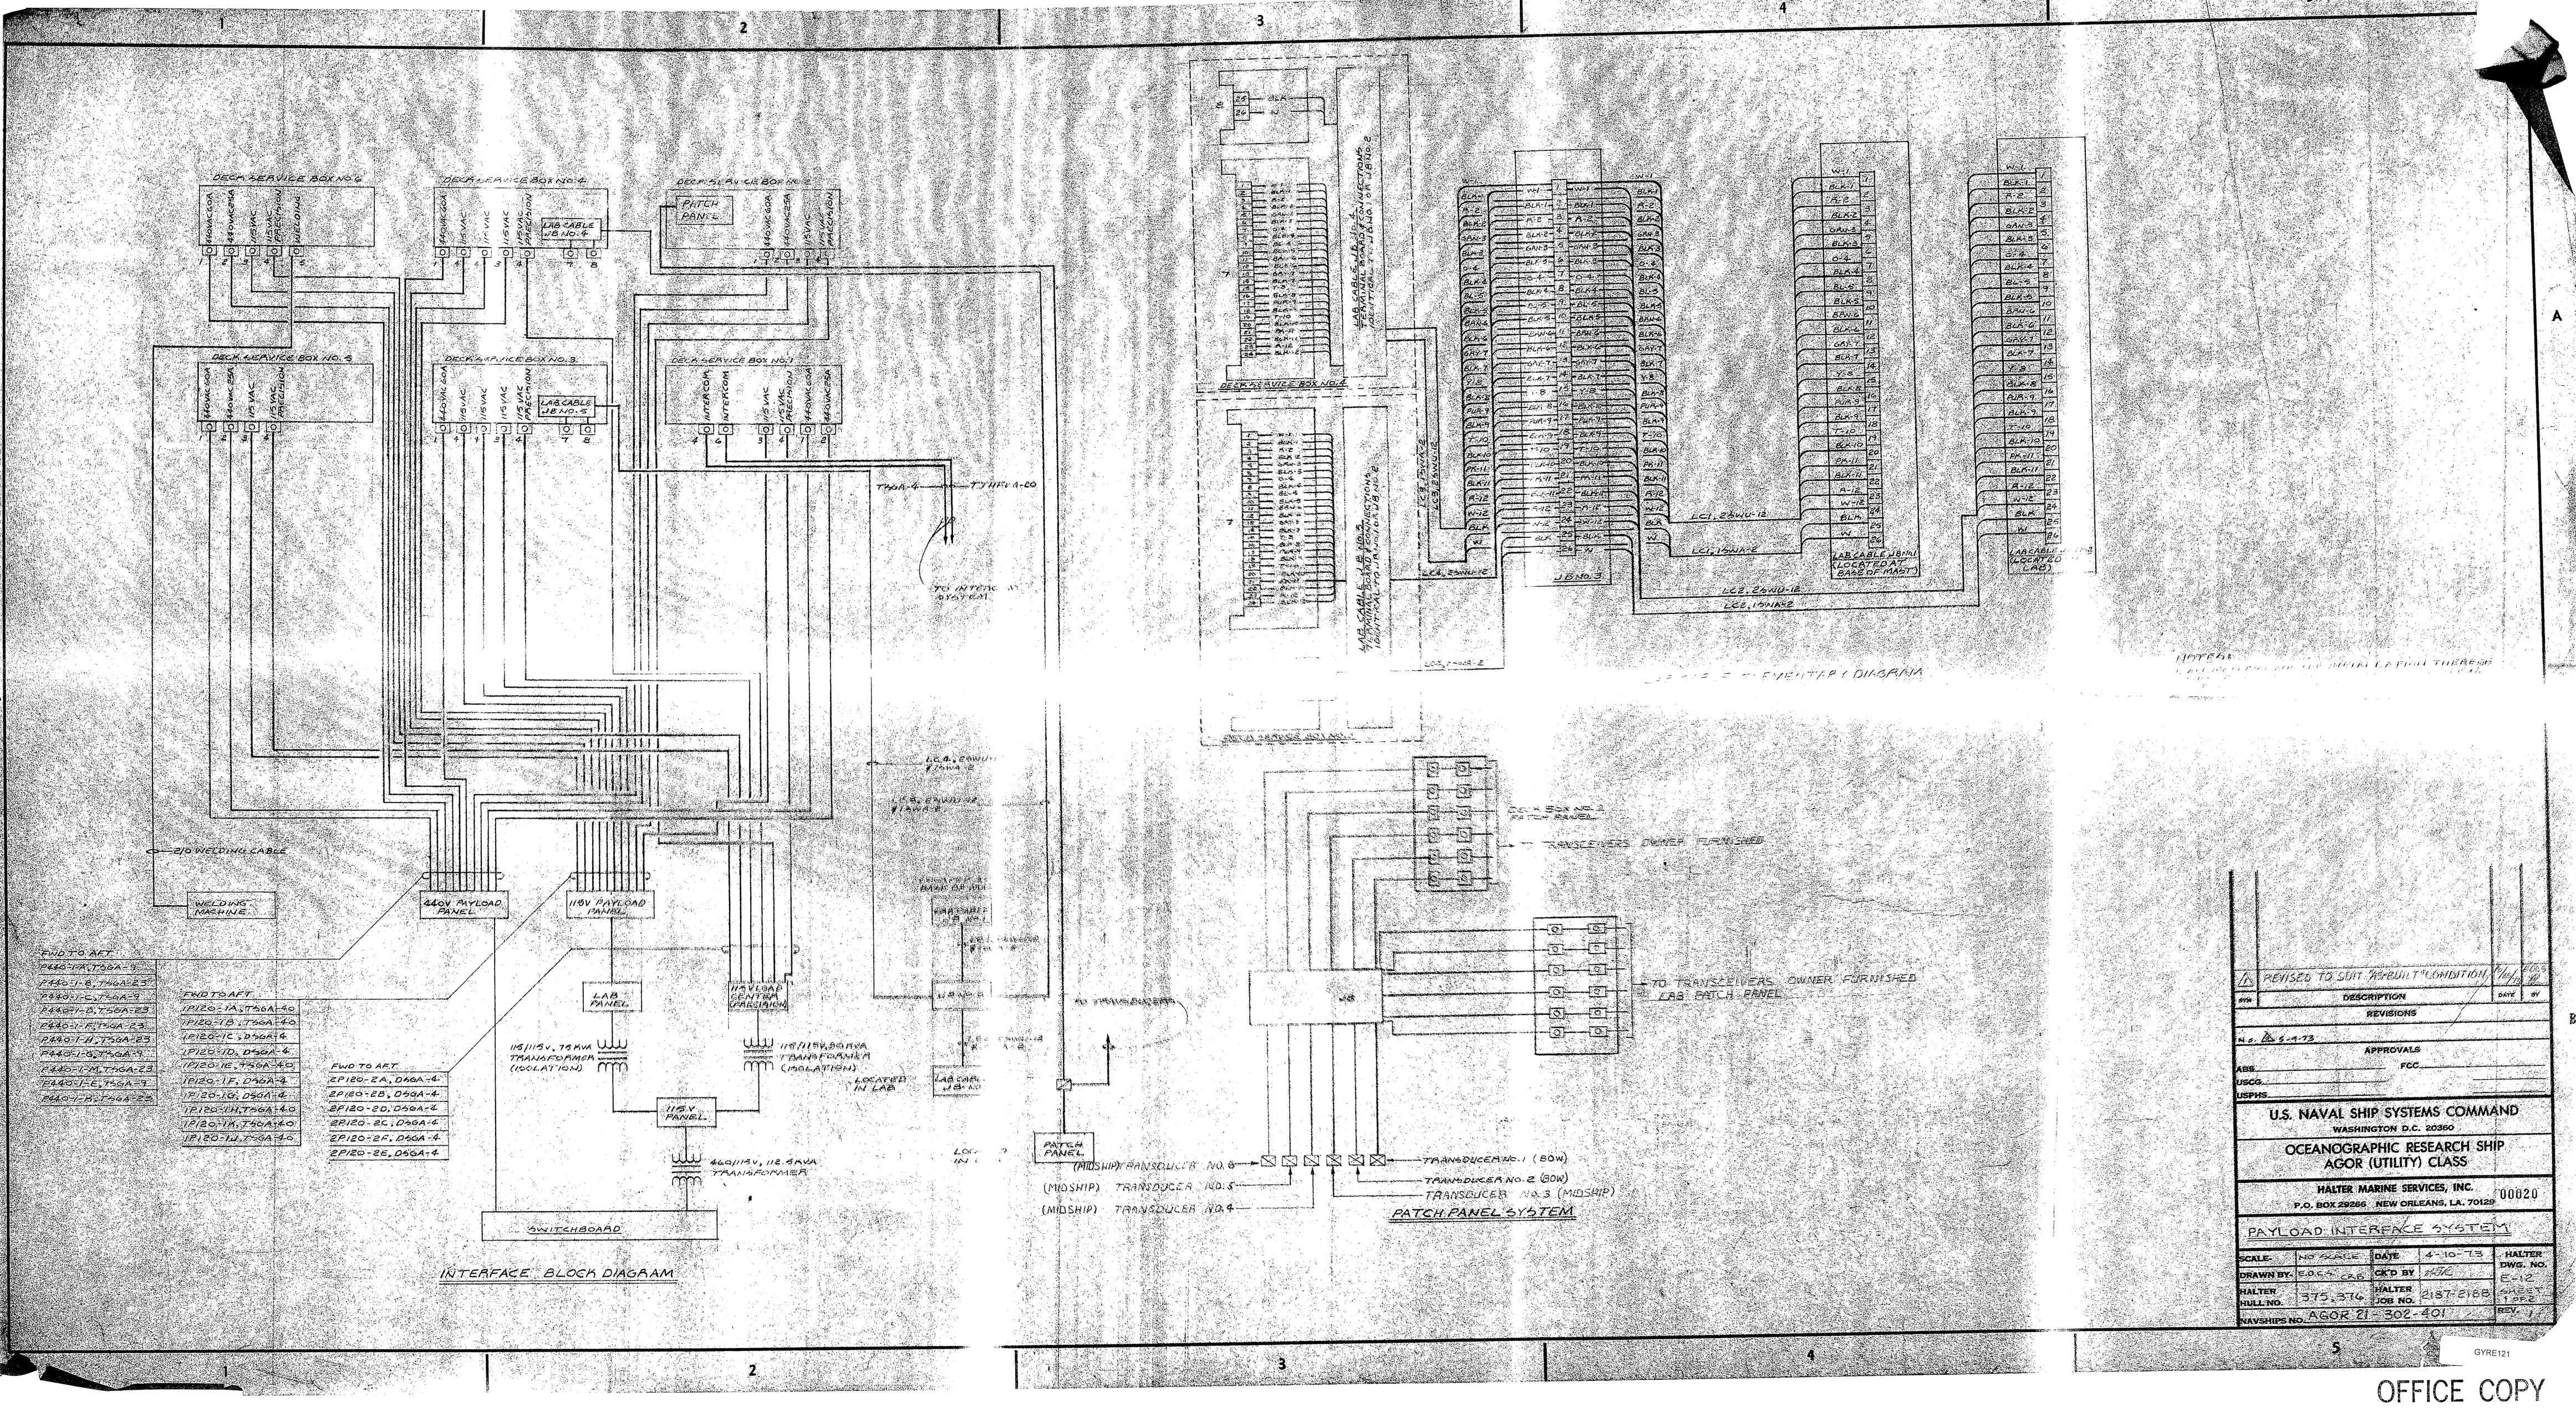


| NO. | DESCRIPTION | DATE | BY |
|---|---|---|---|
| 1 | REVISED TO SUIT "ASBUILT" CONDITION | 11/15/78 | |

REVISIONS

APPROVALS

ABS _____ FCC _____

USCG _____

USPHS _____

U.S. NAVAL SHIP SYSTEMS COMMAND
WASHINGTON D.C. 20360

OCEANOGRAPHIC RESEARCH SHIP
AGOR (UTILITY) CLASS

HALTER MARINE SERVICES, INC.
P.O. BOX 29266 NEW ORLEANS, LA. 70129

00020

PAYLOAD INTERFACE SYSTEM

| | | | |
|---|---|---|---|
| SCALE | NO SCALE | DATE | 4-10-73 |
| DRAWN BY | E.D.C.+ C.A.B. | CK'D BY | A.M.C. |
| HALTER HULL NO. | 375,376 | HALTER JOB NO. | 2187-2188 |
| NAVSHIPS NO. | AGOR 21-302-401 | | |

HALTER DWG. NO. E-12
SHEET 1 OF 2
REV. 1

GYRE121

OFFICE COPY