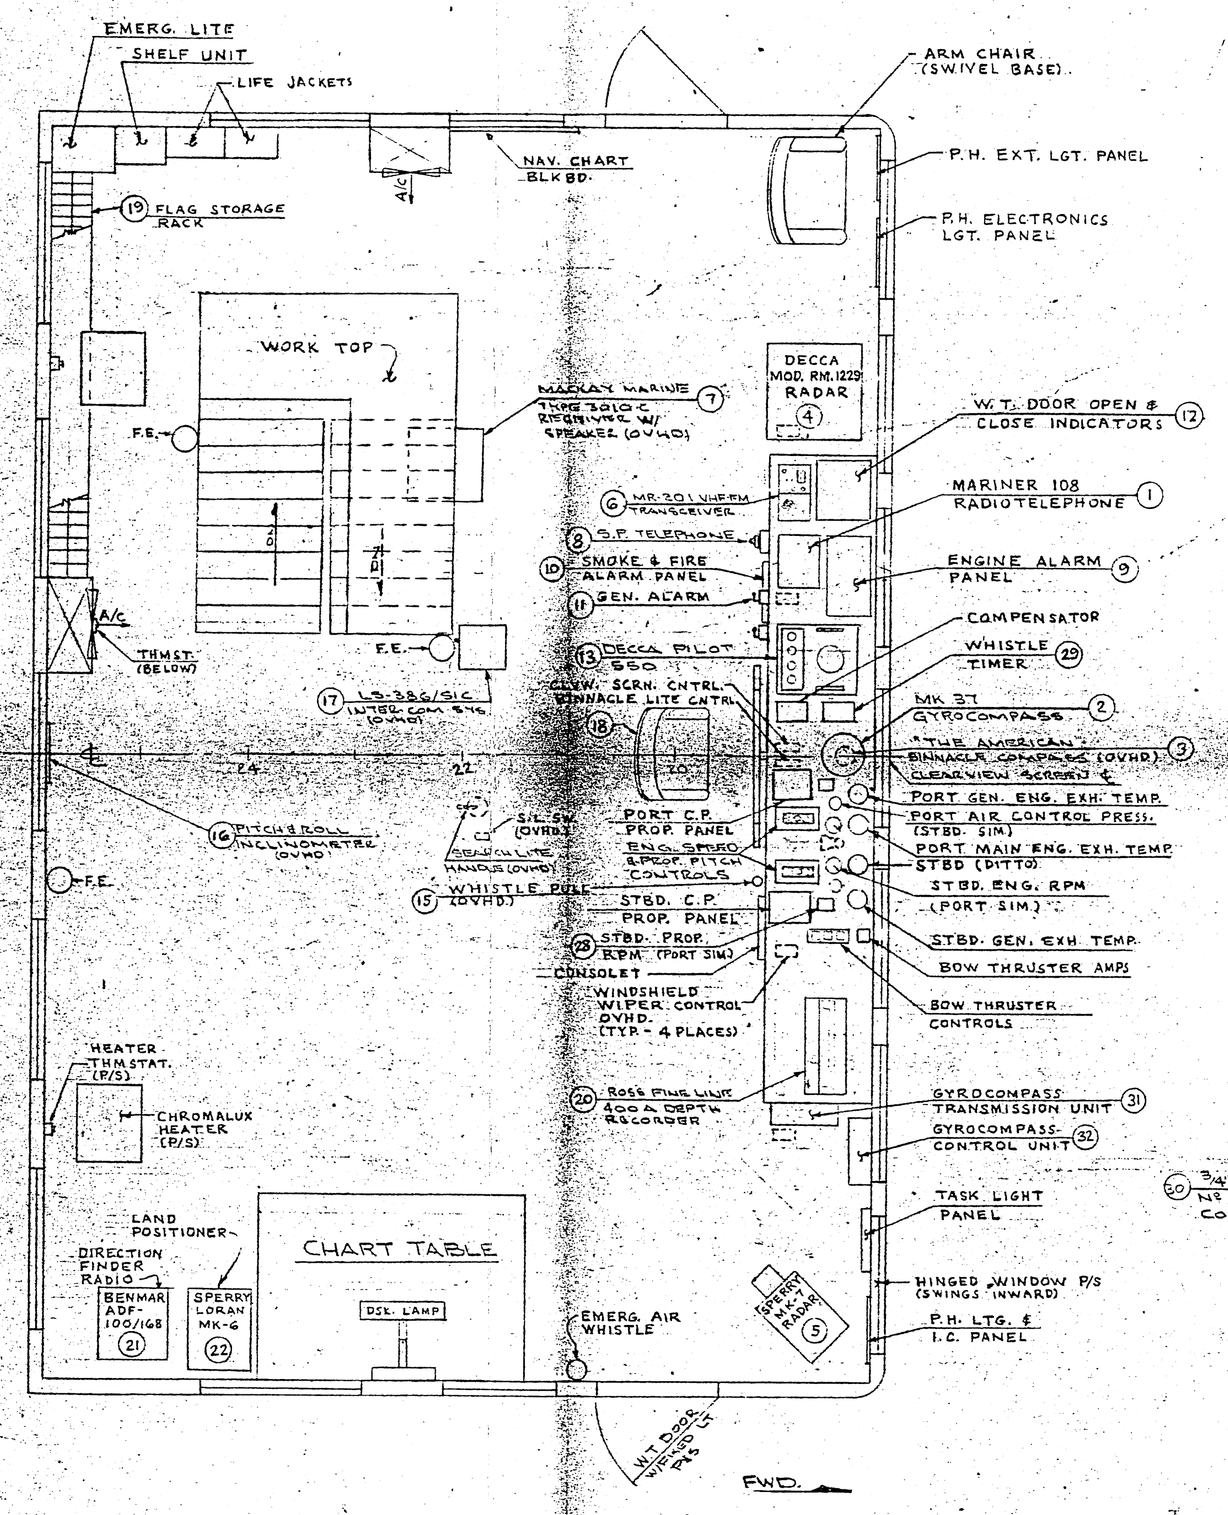

PLAN - PILOT HOUSE

1/2" = 1'-0"

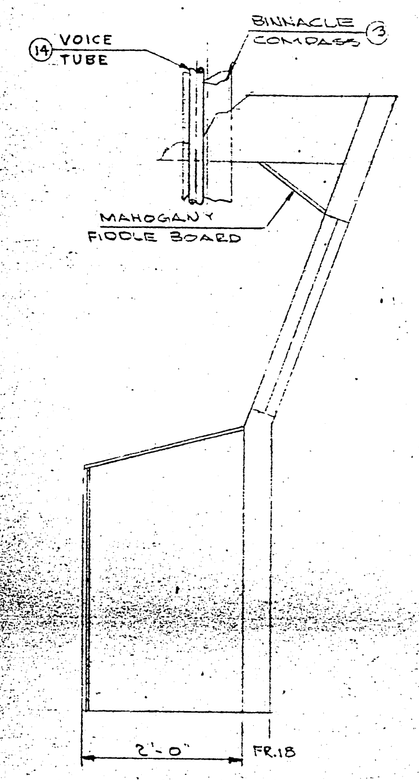

SECT. "B-B"

3/4" = 1'-0"

NOTE:
ALL EQUIPMENT IN CONSOLE & FIDDLE BOARD TO BE RECESSED AND FLUSH MOUNTED AS IS PRACTICAL.

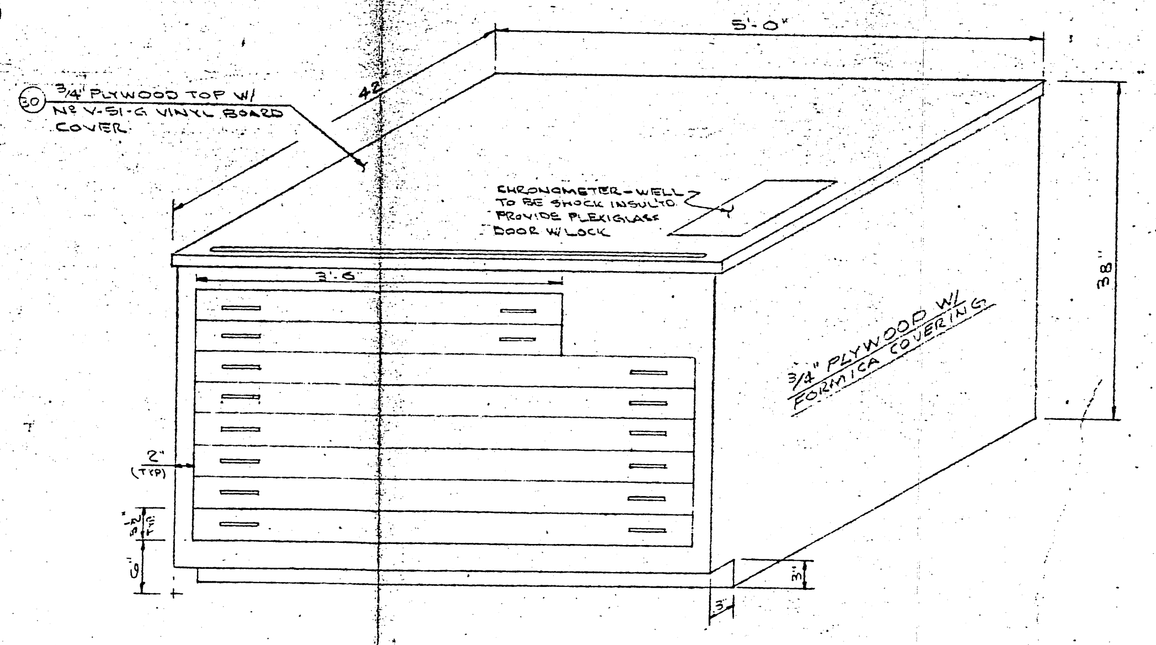

CHART TABLE

1" = 1'-0"

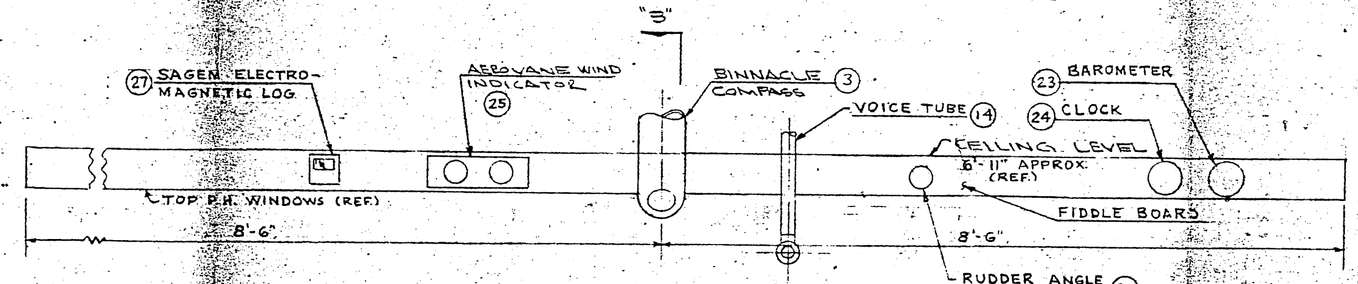

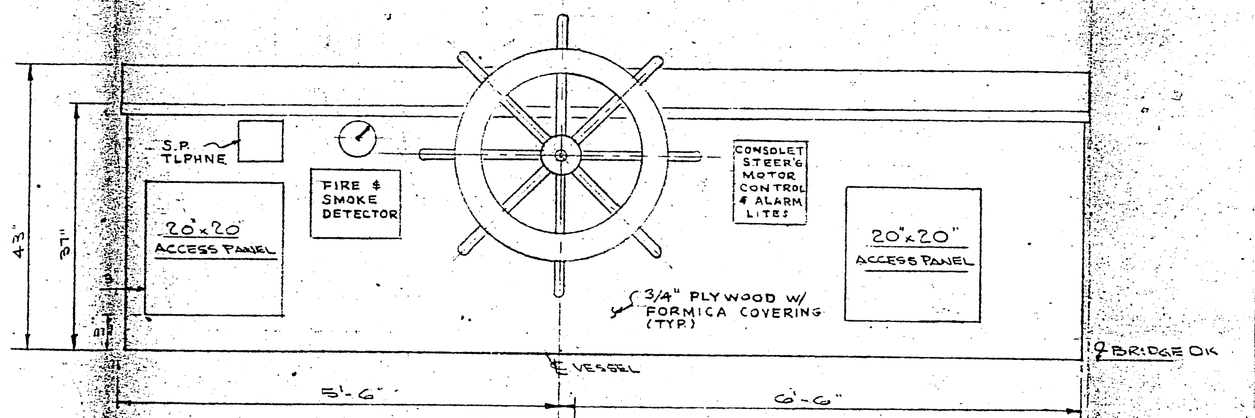

PILOT HOUSE CONSOLE & FIDDLE BD.

LKG. FWD.

3/4" = 1'-0"

BILL OF MATERIALS

ITEM NO.	QUAN	SIZE	DESCRIPTION	COST ITEM	P.O. NO.	VENDOR	DATE REQ'D YARD	DATE RECD
1	1		MARINER-108 RADIO-TELEPHONE	440				
2	1		MK 37-GYROCOMPASS	445				
3	1		"THE AMERICAN" BINNACLE COMPASS	443				
4	1		DECCA RADAR MOD. RM 1229	442				
5	1		SPERRY MK-7 RADAR	442				
6	1		MR-201 VHF-FM TRANSCEIVER	441				
7	1		MACKAY MARINE TYPE 301D-C RECEIVER	441				
8	1		SOUND POWERED TELEPHONE	436				
9	1		ENGINE ALARM PANEL	427				
10	1		SMOKE & FIRE ALARM PANEL	427.1				
11	1		GEN ALARM SWITCH	430				
12	1		W.T. DOOR OPEN & CLOSE INDICATORS	427.1				
13	1		AUTO-PILOT - DECCA PILOT 550	446				
14	1		VOICE TUBE - TO BE FABRICATED BY HMS	460				
15	1		KAHLENBERG D-2 AIR HORN W/HORN PULL	482				
16	1		INCLINOMETER	460				
17	1		LS-3&6/SIC INTERCOM SYSTEM	436				
18	1		STOOL	460				
19	1		FLAG STOWAGE RACK W/60 COMPARTMENTS	460				
20	1		ROSS FINE LINE 400 A DEPTH RECORDER	445				
21	1		BENMAR - ADF 100/16B	444				
22	1		LORAN MOD. MK.-6	444				
23	1		BAROMETER - CHROME FINISHED	460				
24	1		8 1/2" DIA CLOCK - CHROME FINISHED	460				
25	1		AERO VANE WIND INDICATOR	440				
26	1		RUDDER ANGLE INDICATOR	449				
27	1		SAGEN - ELECTRO-MAGNETIC LOG	444				
28	2		PITCH & ROLL INCLINOMETER	427				
29	1		WHISTLE TIMER	482				
30	18'		NE V-91-G VINYL BOARD COVER	460				
31	1		GYROCOMPASS TRANSMISSION UNIT	445				
32	1		GYROCOMPASS CONTROL UNIT	445				

SYM	DESCRIPTION	DATE	BY
1	AS BUILT	11-13-73	CJR

REVISIONS

N.O Δ 5-2-73

APPROVALS

ABS

USCG

USPHS

OFFICE COPY

U.S. NAVAL SHIP SYSTEMS COMMAND
WASHINGTON D.C. 20360

OCEANOGRAPHIC RESEARCH SHIP
AGOR (UTILITY) CLASS

HALTER MARINE SERVICES, INC.
P.O. BOX 29266 , NEW ORLEANS, LA. 70129

PILOT HOUSE ARRGT.

SCALE-	NOTED	DATE	4-30-73	HALTER DWG. NO.
DRAWN BY-	FERRELL GARNER	CK'D BY	JOWERS	A-3
HALTER HULL NO.	375-76	HALTER JOB NO.	2187-88	
NAVSHIPS NO.	AGOR 21-145-502			REV. 1

00006

GYRE123