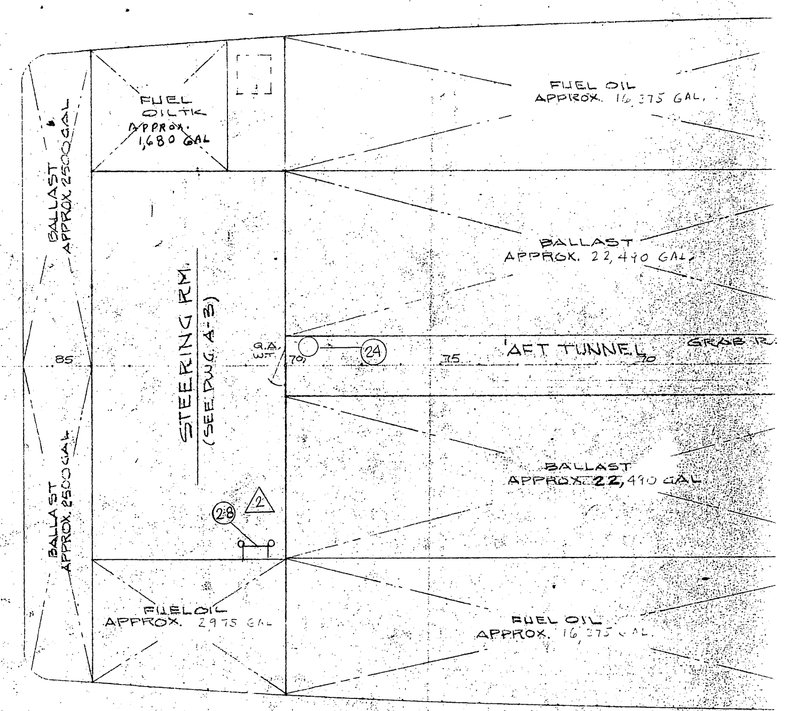

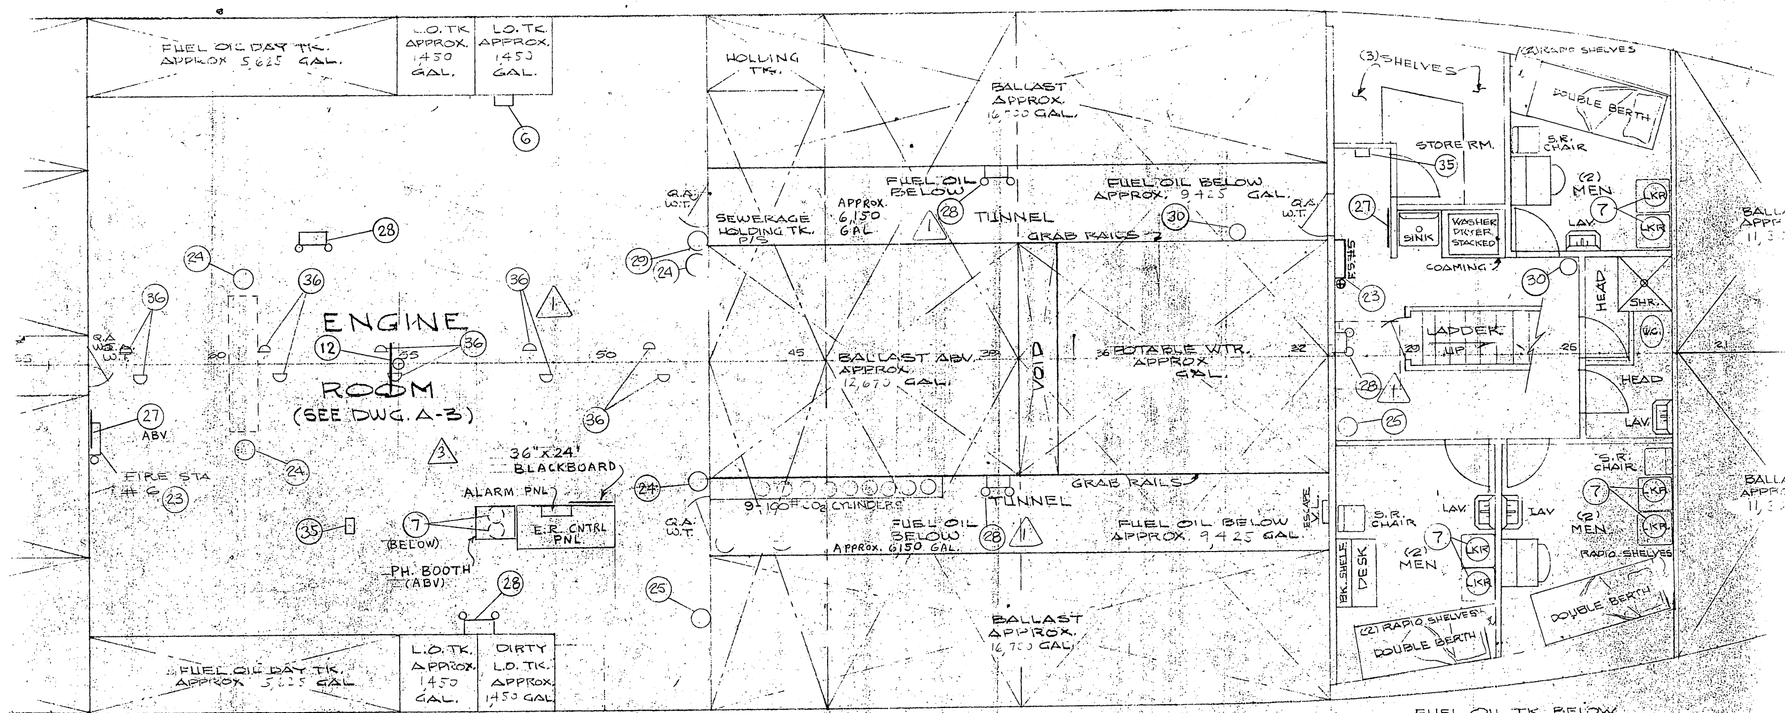

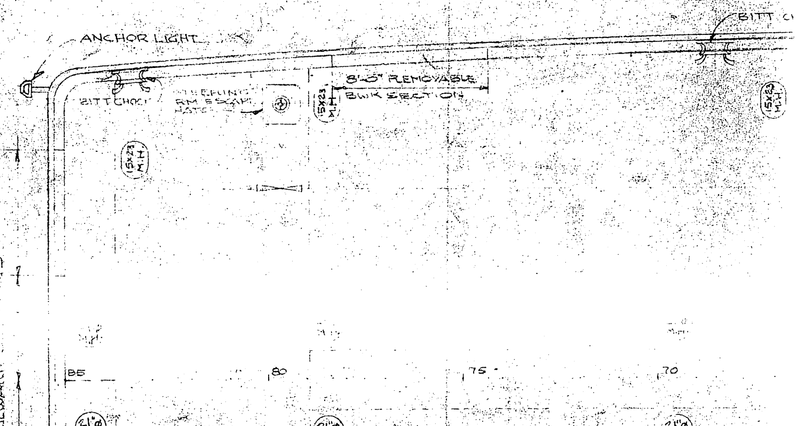

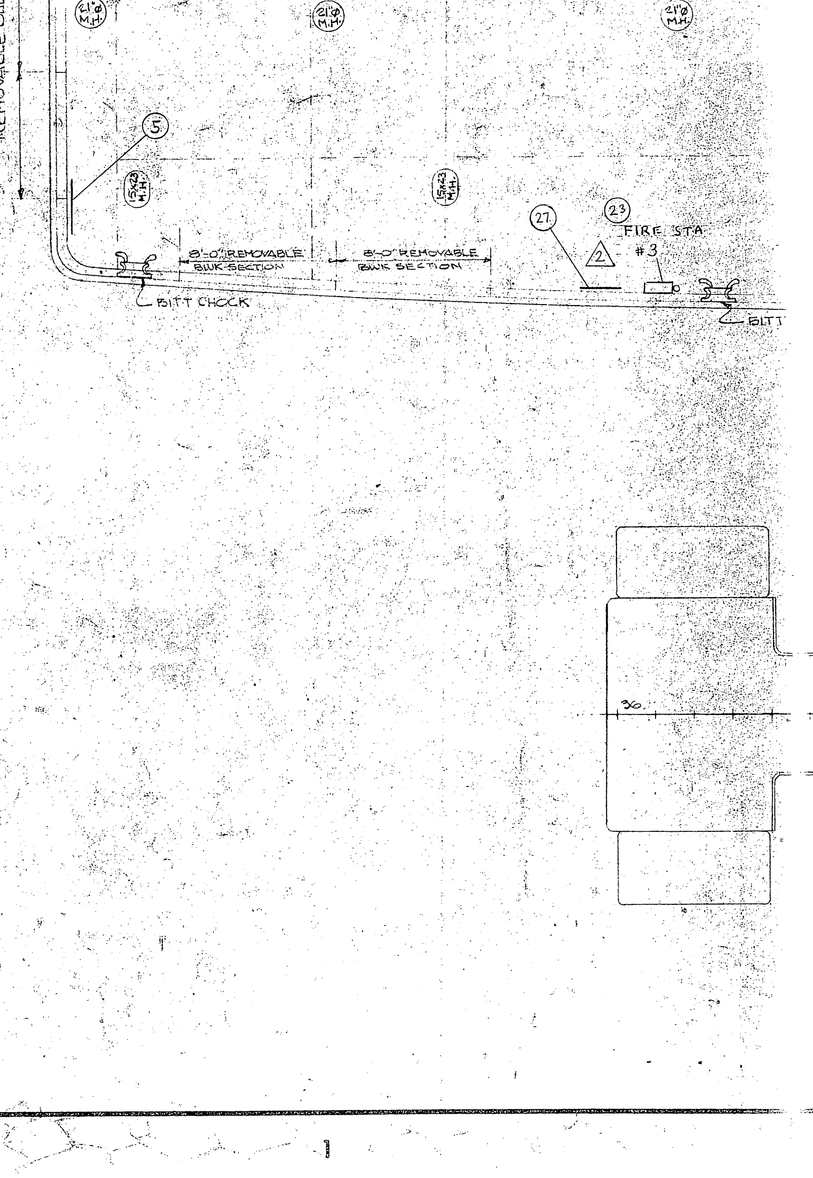

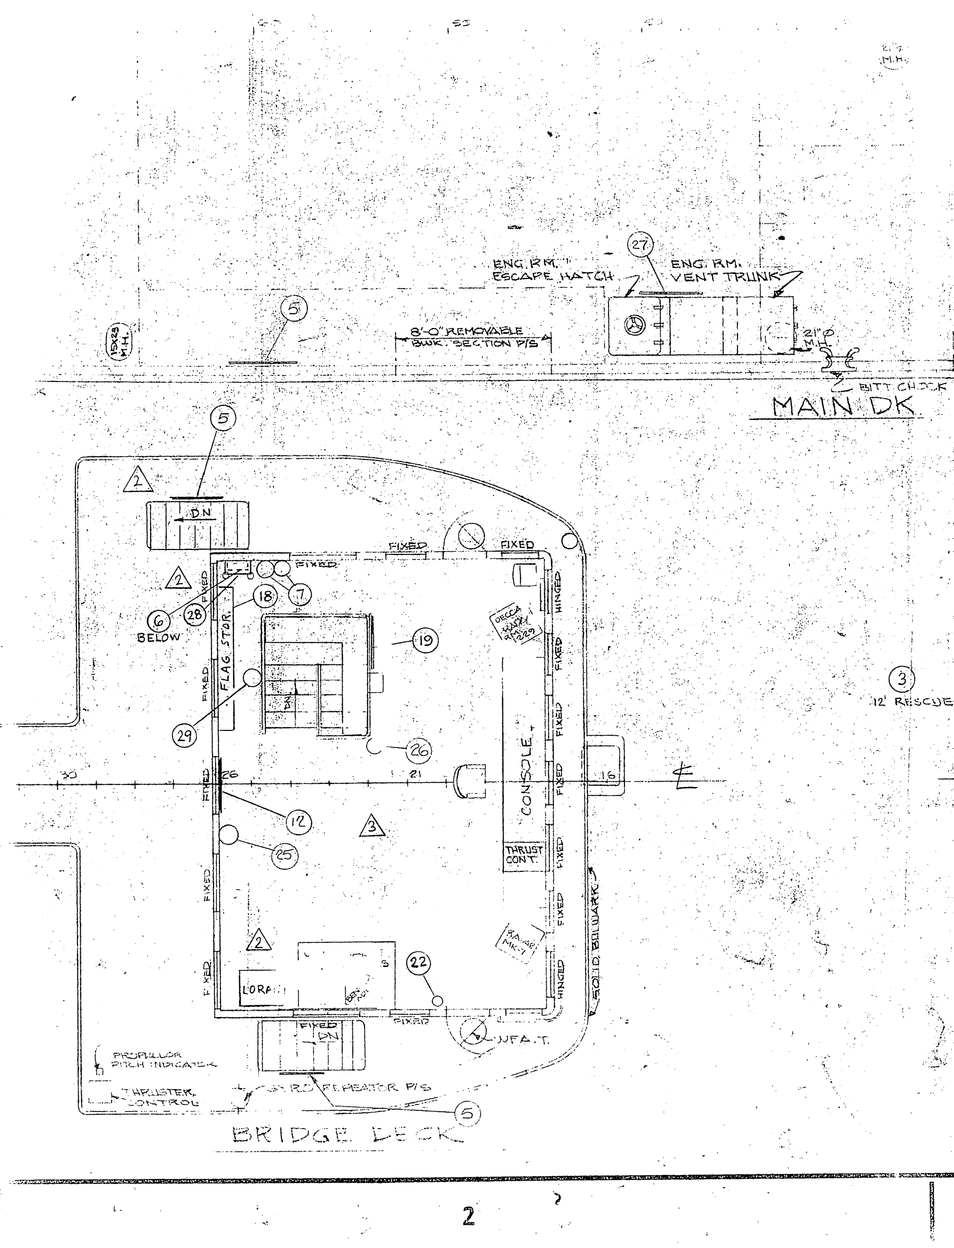

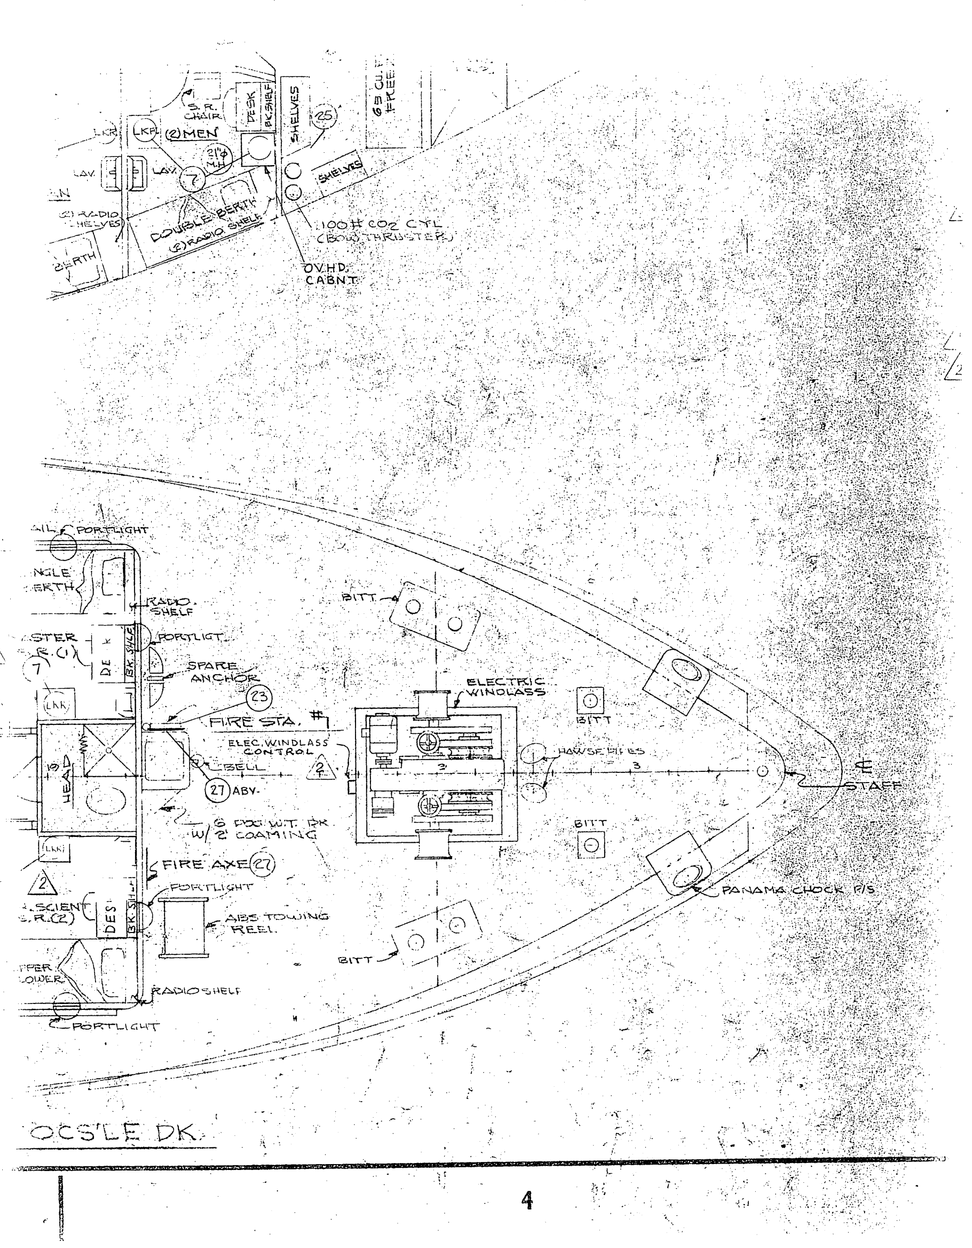

BILL OF MATERIALS

QUAN	SIZE	DESCRIPTION	COAST GUARD ITEM	PD NO.	VENDOR	CERTIFICATE OR VOUCHER	WEIGHT EACH
4	25 MAN	LIFE RAFTS	160				
1	—	LIFE BOAT RADIO MODEL RCA -RB5005					
1	12'	FIBERGLASS RESCUE & LIFE BOAT W/EQUIPMENT, COVER & FLOTATION TKS.				C.G. #11600-108-R	
3	24"ϕ	BLACK ANCHOR BALLS					
6	30" DIA.	LIFE RINGS - PLASTIC COVERED W/WHITE LITES, 4 W/SQUARE, 2 W/TS LINE					
3	—	FIRST AID KITS					
25	ADULT	LIFE JACKETS W/LIGHTS & WHISTLE					
1	—	LINE GUN W/LINE					
1	—	HAND HELD ROCKET FLARE KIT #K-200 W/6 ORANGE & 6 RED FLARES - KILGORE DEER 160-238 OR SUBSTANCE EQUIV.					
1	—	FLARE CONTAINER					
1	—	SOUND LEAD WITH 120 LINE					
2	—	INCLINOMETERS					
1	—	PORTABLE LOUD HAILER AUDIO EQUIP. 5618 PR EQUAL					
2	—	PORTABLE SIGNAL LITES GAM-13 SMITH ERL EQUAL					
6	—	MOORING LINES NYLON 5" CIRC. 60 FM EA.					
6	—	FENDERS - GOODRICH 100 GAL. INFLAT. CAP. EQ.					
6	—	FENDERS 2516, ROPE					
1	—	FLAG LOCKER					
1	—	COURSE BOARD					
1	16'X2'	ALUMINUM GANGWAY W/HAND RAILS					
2	—	FIREMAN'S OUTFIT W/RESCUE BREATHING APPARATUS					
1	—	HAND PUMP OPERATED FUEL MARINE #FL-NCN-NEPTUNE					
6	—	FIRE HOSES W/COUPLINGS, FOG & SPANNER, W					45
8	15 LBS.	C-2 CO_2 FIRE EXTINGUISHERS					
3	4 LBS.	C-1 CO_2 FIRE					
1	2 3/4 LBS	DRY CHEMICAL UNIT					
2		ENG. RM. CO_2 PULL BOX					
1		BOW THRUSTER CO_2 PULL BOX					
1		EMERGENCY BLOWER STOP					
1		EMERGENCY F.O. PUMP STOP					
3		PRY-ALARM (SMOKE/FLAME) DETECTOR					
6	13 SEE VENDOR DWG	FIXED CO_2 SYSTEM BAFFLE NOZZLE					
37	1	EMERGENCY ENGINE STOP					

* DUAL PURPOSE BUTTON ACTIVATES 33 & 34 SIMULTANEOUSLY

NO.	DESCRIPTION	DATE	BY
3	RELOCATED LOUD HAILER & SIGNAL LITES TO LOCKER - RELOCATED INCLINOMETER - RELOCATED LIFE JACKETS IN ENG. ROOM - RELOCATED ICE MAKER - & BLACK BOARD	11/1/73	CJR
2	UPDATED "AS BUILT"		
1	AS BUILT	10/22/73	CJR
	LOCATED FIXED CO_2 SYS. NOZZLES & EMER. STOP P. 220 & ADDED RESCUE BOAT HANDLING EQUIP. & RELOCATED ELEC. WINDLASS CONTROL & REV. B.O.M.	9/24/73	CJR

REVISIONS

NO ⚠ 4-24-73

APPROVALS

ABS ⚠ 8-13-73 FCC

USCG

USPHS

U.S. NAVAL SHIP SYSTEMS COMMAND
WASHINGTON D.C. 20360

OCEANOGRAPHIC RESEARCH SHIP
AGOR (UTILITY) CLASS

HALTER MARINE SERVICES, INC. 00005
P.O. BOX 29266 NEW ORLEANS, LA. 70129

SAFETY EQUIPMENT

SCALE-	3/16"=1'-0"	DATE	1-12-73	HALTER DWG. NO.
DRAWN BY-	H.R. Keller	CK'D BY	JOWERS	A-5
HALTER HULL NO.	376 376	HALTER JOB NO.	2187 2185	REV.
NAVSHIPS NO.	AGOR 21-661:507			

OFFICIAL COPY

GYRE136