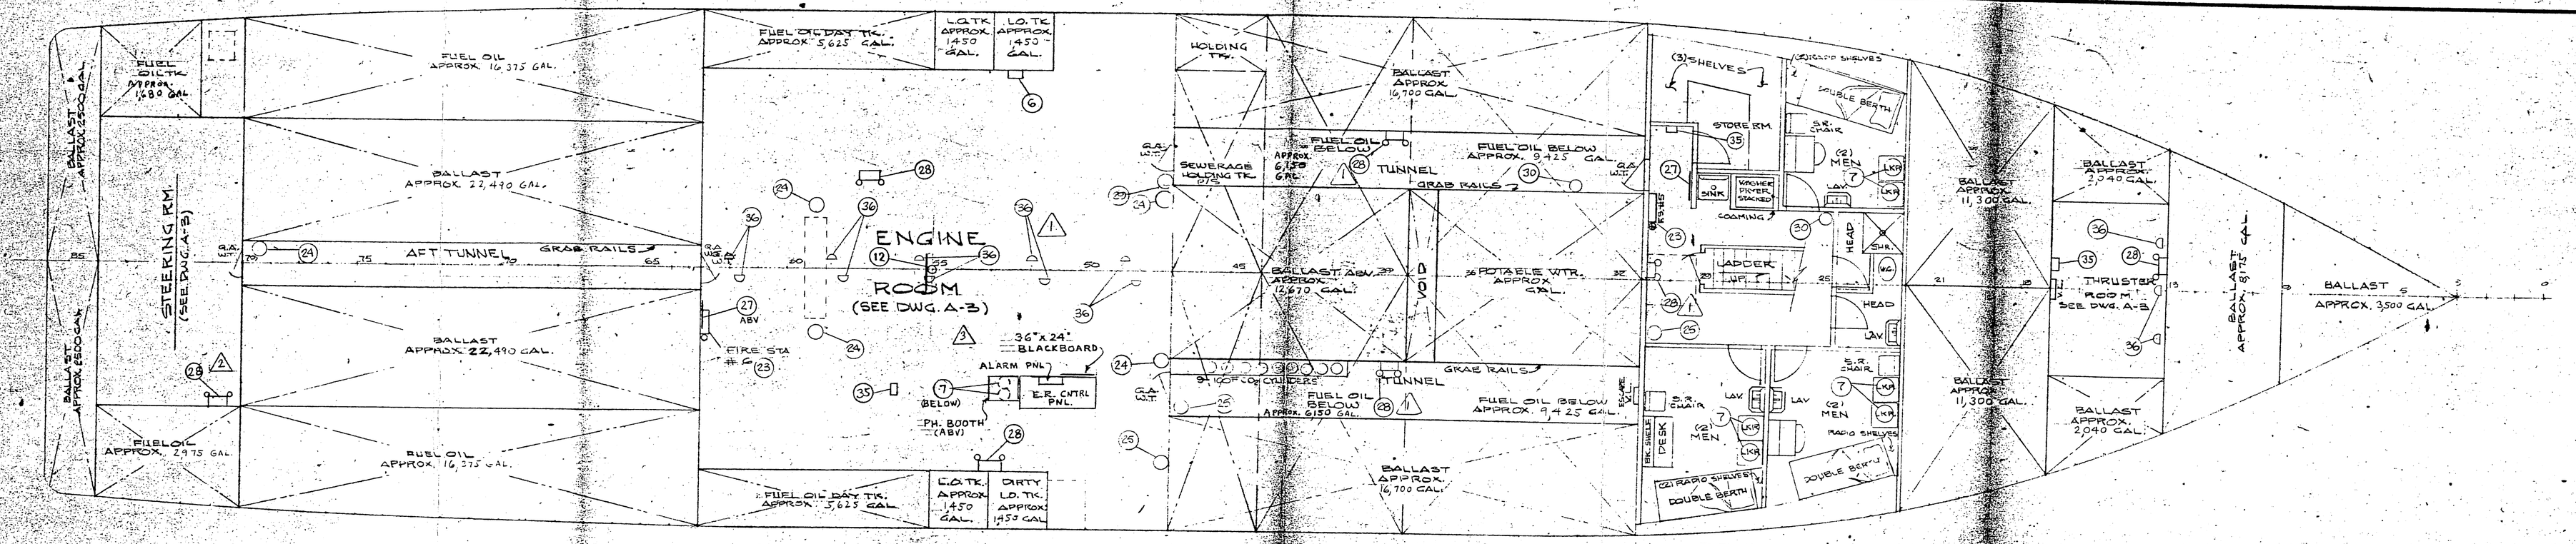

HOLD PLAN

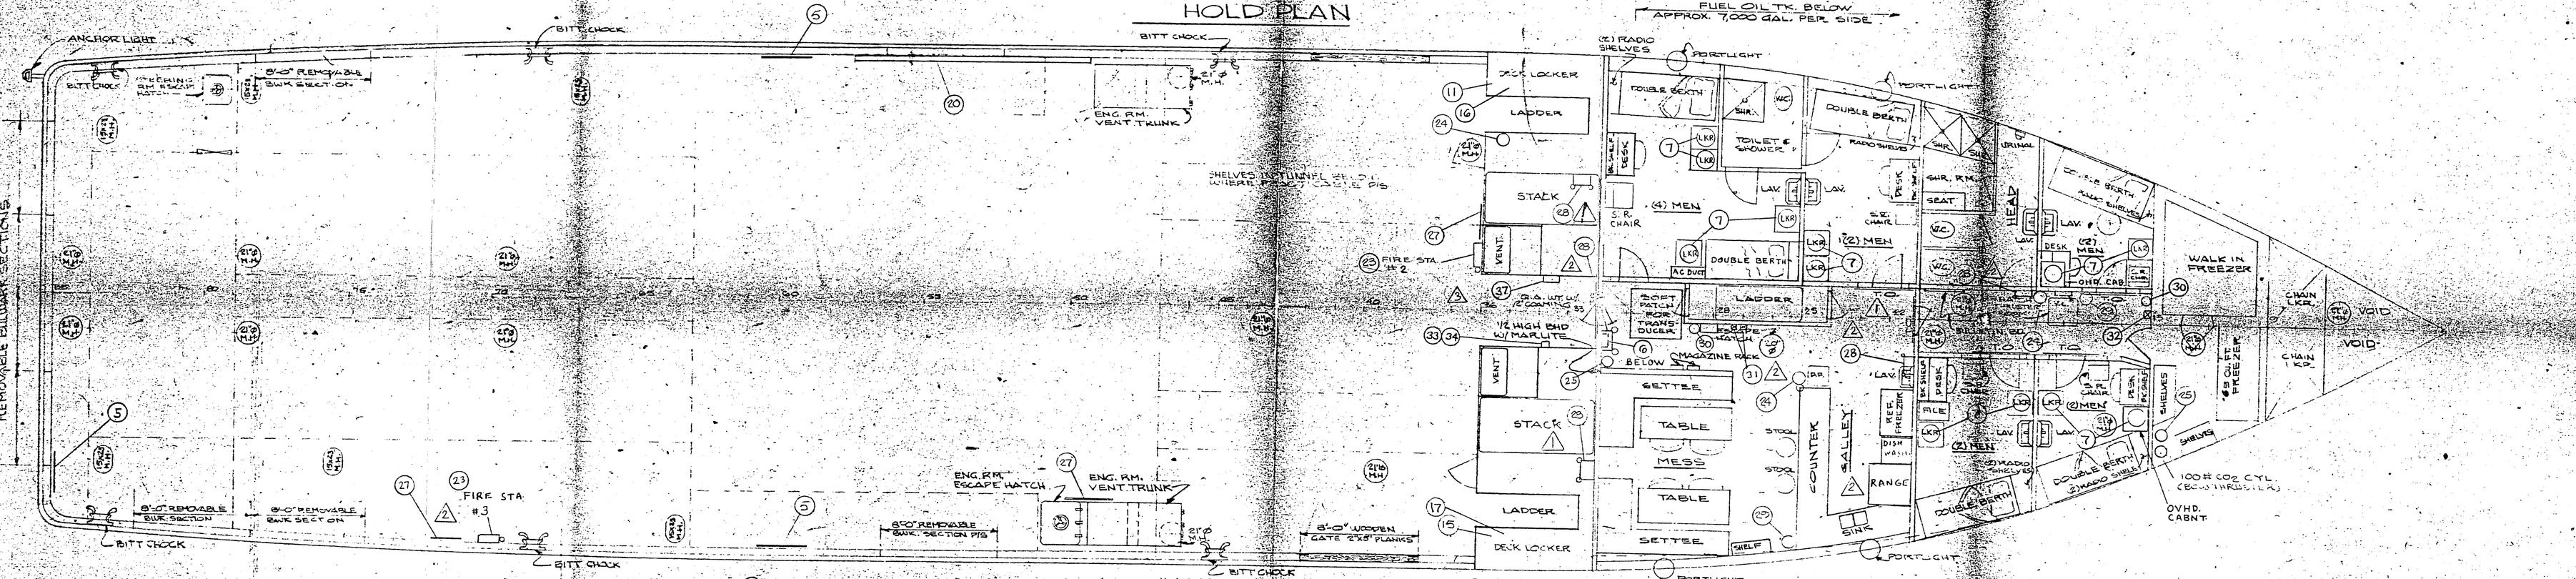

MAIN DK.

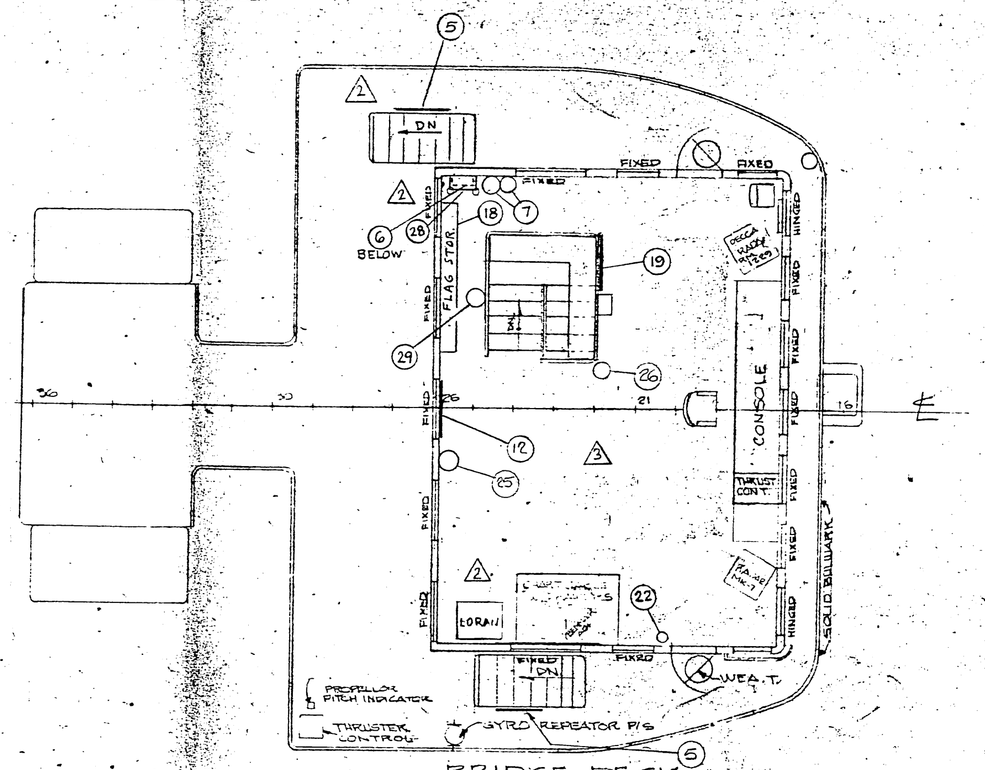

BRIDGE DECK

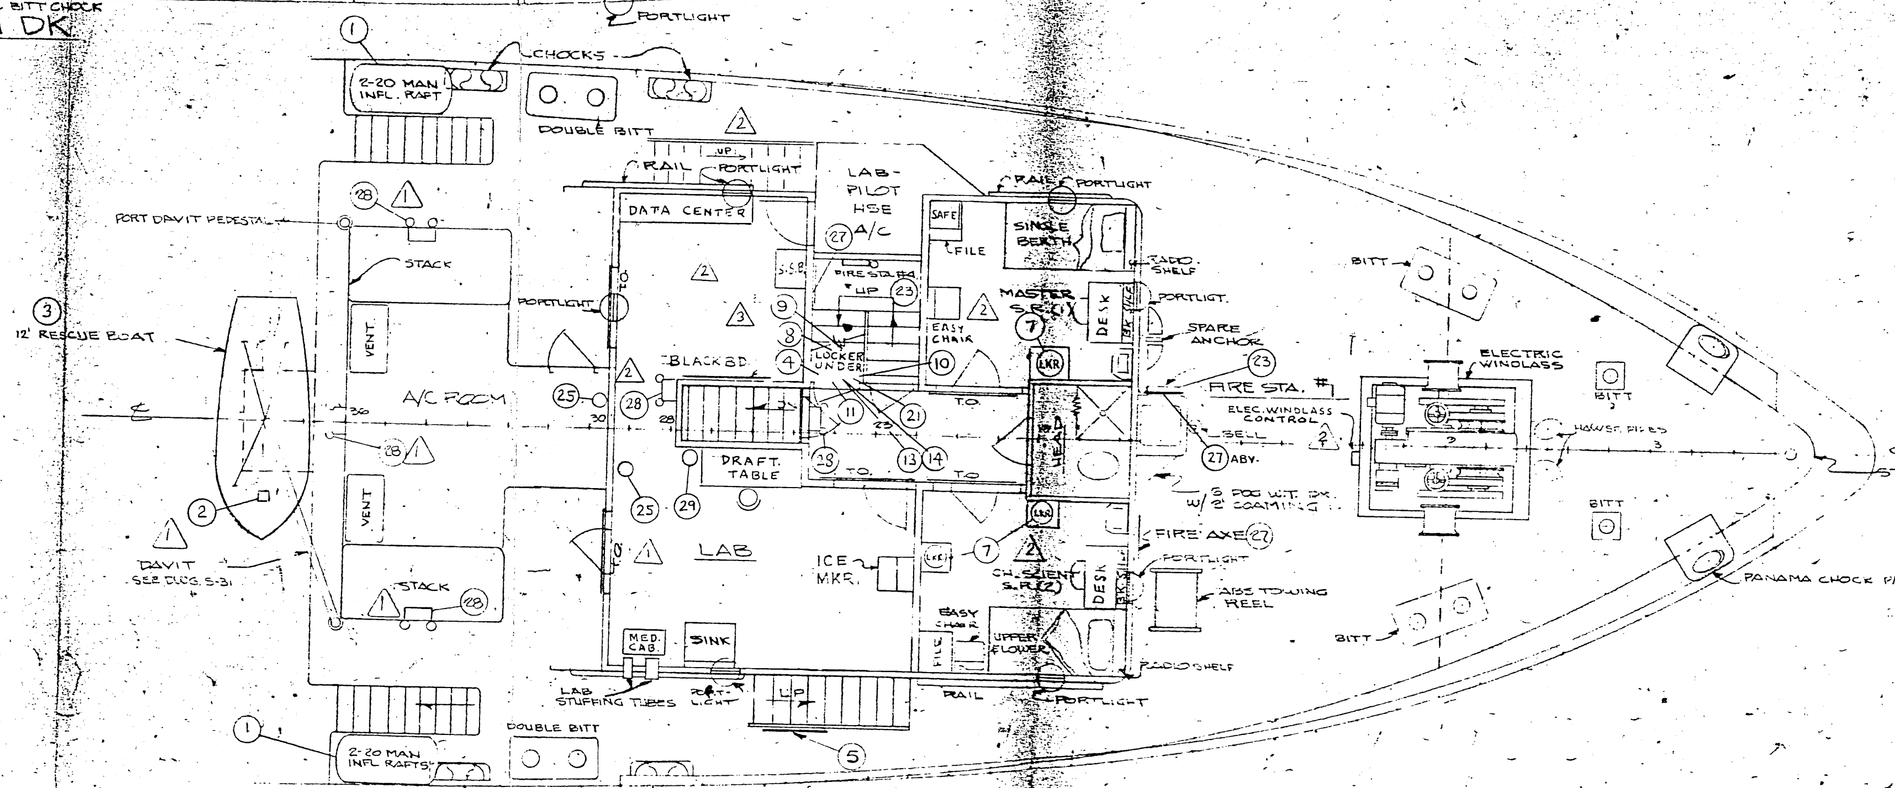

FOC'SLE DK.

BILL OF MATERIALS

NO. REQ'D PER SHIP	SPARE	SIZE	DESCRIPTION	COST ITEM	P.O. NO.	VENDER	DATE RECD YARD	DATE RECD GMA
1	4	60 MAN	LIFE RAFTS	450				
2	1	–	LIFE BOAT RADIO MODEL RCA LR8803					
3	1	12'	FIBERGLASS RESCUE & LIFE BOAT W/EQUIPMENT, COVER & FLOATATION TKS		C.J. HENDRY	9/5/73		
4	3	24"	BLACK ANCHOR BALLS					
5	6	30" DIA.	LIFE RINGS-PLASTIC COVERED W/WHITE LITES, 4-WHISKLINE 2¼" FLINE					
6	3	–	FIRST AID KITS					
7	65	ADULT	LIFE JACKETS W/LIGHTS & STOWAGE					
8	1	–	LINE GUN W/LINE					
9	1	–	HAND HELD ROCKET FLARE U.T.P.I.C. 2000 W/6 FLARES & 4 RED FLARES - KILGORE, PER 160.055 OF SUBCHAP. O, 1.5 CFR.					
10	1	–	FLARE CONTAINER					
11	1	–	SOUND LEAD WITH 120' LINE					
12	2	–	INCLINOMETERS					
13	1	–	PORTABLE LOUD HAILER AUDIO EQUIP 3618 OR EQUAL					
14	2	–	PORTABLE SIGNAL LITES SAL-TRON 6RL OR EQUAL					
15	6	–	MOORING LINES NYLON 5" CIRC. 90 FM. EA.					
16	6	–	TENDERS - GOODRICH 100 GAL. INFLATE OR EQ.					
17	6	–	FENDERS 22"Ø. ROPE					
18	1	–	FLAG LOCKER					
19	1	–	COURSE BOARD					
20	1	16'-2"	ALUMINUM GANGWAY W/HAND RAILS					
21	2	–	FIREMAN'S OUTFIT W/RESCUE BREATHING APPARATUS					
22	1	–	HAND PORTABLE FOAM FUEL MARINE AIR FOAM - NEPTUNE					
23	6	–	FIRE HOSES W/NOZZLE RACK & SPANNER W/WRENCH				4/73	
24	8	15 lb.	C-2 CO_2 FIRE EXTINGUISHERS					
25	8	4 lb.	C-1 CO_2 FIRE EXT.					
26	1	2½ lb.	DRY CHEMICAL UNIT					
27	6	–	FIRE AXES W/SHTS					
28	40	–	AUTOMATIC FIREMENT DETECTOR SYSTEM					
29	3	–	PURPLE K FIRE EXT.					
30	4	10 lb.	ABC DRY CHEM EXT.					
31	2	–	ENG. RM. CO_2 PULL BOX					
32	1	–	BOW THRUSTER CO_2 PULL BOX					
33*	1	–	EMERGENCY BLOWER STOP					
34*	1	–	EMERGENCY F.O. PUMP STOP					
35	3	–	DRY ALARM (SMOKE/FLAME) DETECTOR					
36	13	SHLD. VENDOR, SHC	FIXED CO_2 SYSTEM BAFFLE NOZZLE					
37	1		EMERGENCY ENGINE STOP					

* DUAL PURPOSE BUTTON ACTIVATES 33 & 34 SIMULTANEOUSLY

SYM	DESCRIPTION	DATE	BY
	REVISIONS		
4	RELOCATED LOUD HAILER & SIGNAL LITES TO LOCKER - RELOCATED INCLINOMETER - RELOCATED LIFE JACKETS IN ENG. ROOM. RELOCATED ICE MAKER & BLACKBOARDS	11/7/73	CJR
3	UPDATED "AS BUILT"		
2	AS BUILT	10/22/73	CJR
1	LOCATED FIXED CO_2 SYS. NOZZLES & EMER. LOCK CONS & ADDED RESCUE BOAT HANDLING EQUIP. RELOCATED ELEC. WINDLASS CONTROL & REV. B.O.M.	9/12/73	

NO. 4-24-73

APPROVALS

ABS 8-13-73

USCG

USPHS

OFFICE COPY

U.S. NAVAL SHIP SYSTEMS COMMAND
WASHINGTON D.C. 20360

OCEANOGRAPHIC RESEARCH SHIP
AGOR (UTILITY) CLASS

HALTER MARINE SERVICES, INC.
P.O. BOX 29266 NEW ORLEANS, LA. 70129

SAFETY EQUIPMENT

00005

SCALE-	3/16"=1'-0"	DATE	1-13-73	HALTER DWG. NO.
DRAWN BY-	Montalbano	CK'D BY	Jowers	
HALTER HULL NO.	376 376	HALTER JOB NO.	2187 2188	A-2
NAVSHIPS NO.	AGOR 21-601-507			REV. -

GYRE137