

ALTERATIONS	
REMOVED PORTLIGHTS & ADDED TOILET PER PARTS 15 OF 16/1	
ADDED WELDING DETAILS	
APPROVED AS APPROVAL	
ALTERED TO AS BUILT	

REFERENCE PLANS	

GENERAL NOTES

1. ALL WORK & WELDING TO BE IN ACCORDANCE WITH A.S.S. RULES & REGULATIONS.


2. REF 1500-2 FOR TONGUE & GROOVE DECK.

172 X 36 X 15 MIN. G. I. PLATE
 AGOR-2.1
 HALTER MARINE BULL 375



TEXAS A & M
 OCEAN RESEARCH VESSEL
 DECK HOUSE
 ADDITIONS
 1/15/15
 SCALE: 3/8" = 1'-0" (1/4" = 1'-0" LIGHT)

OFFICE CO.

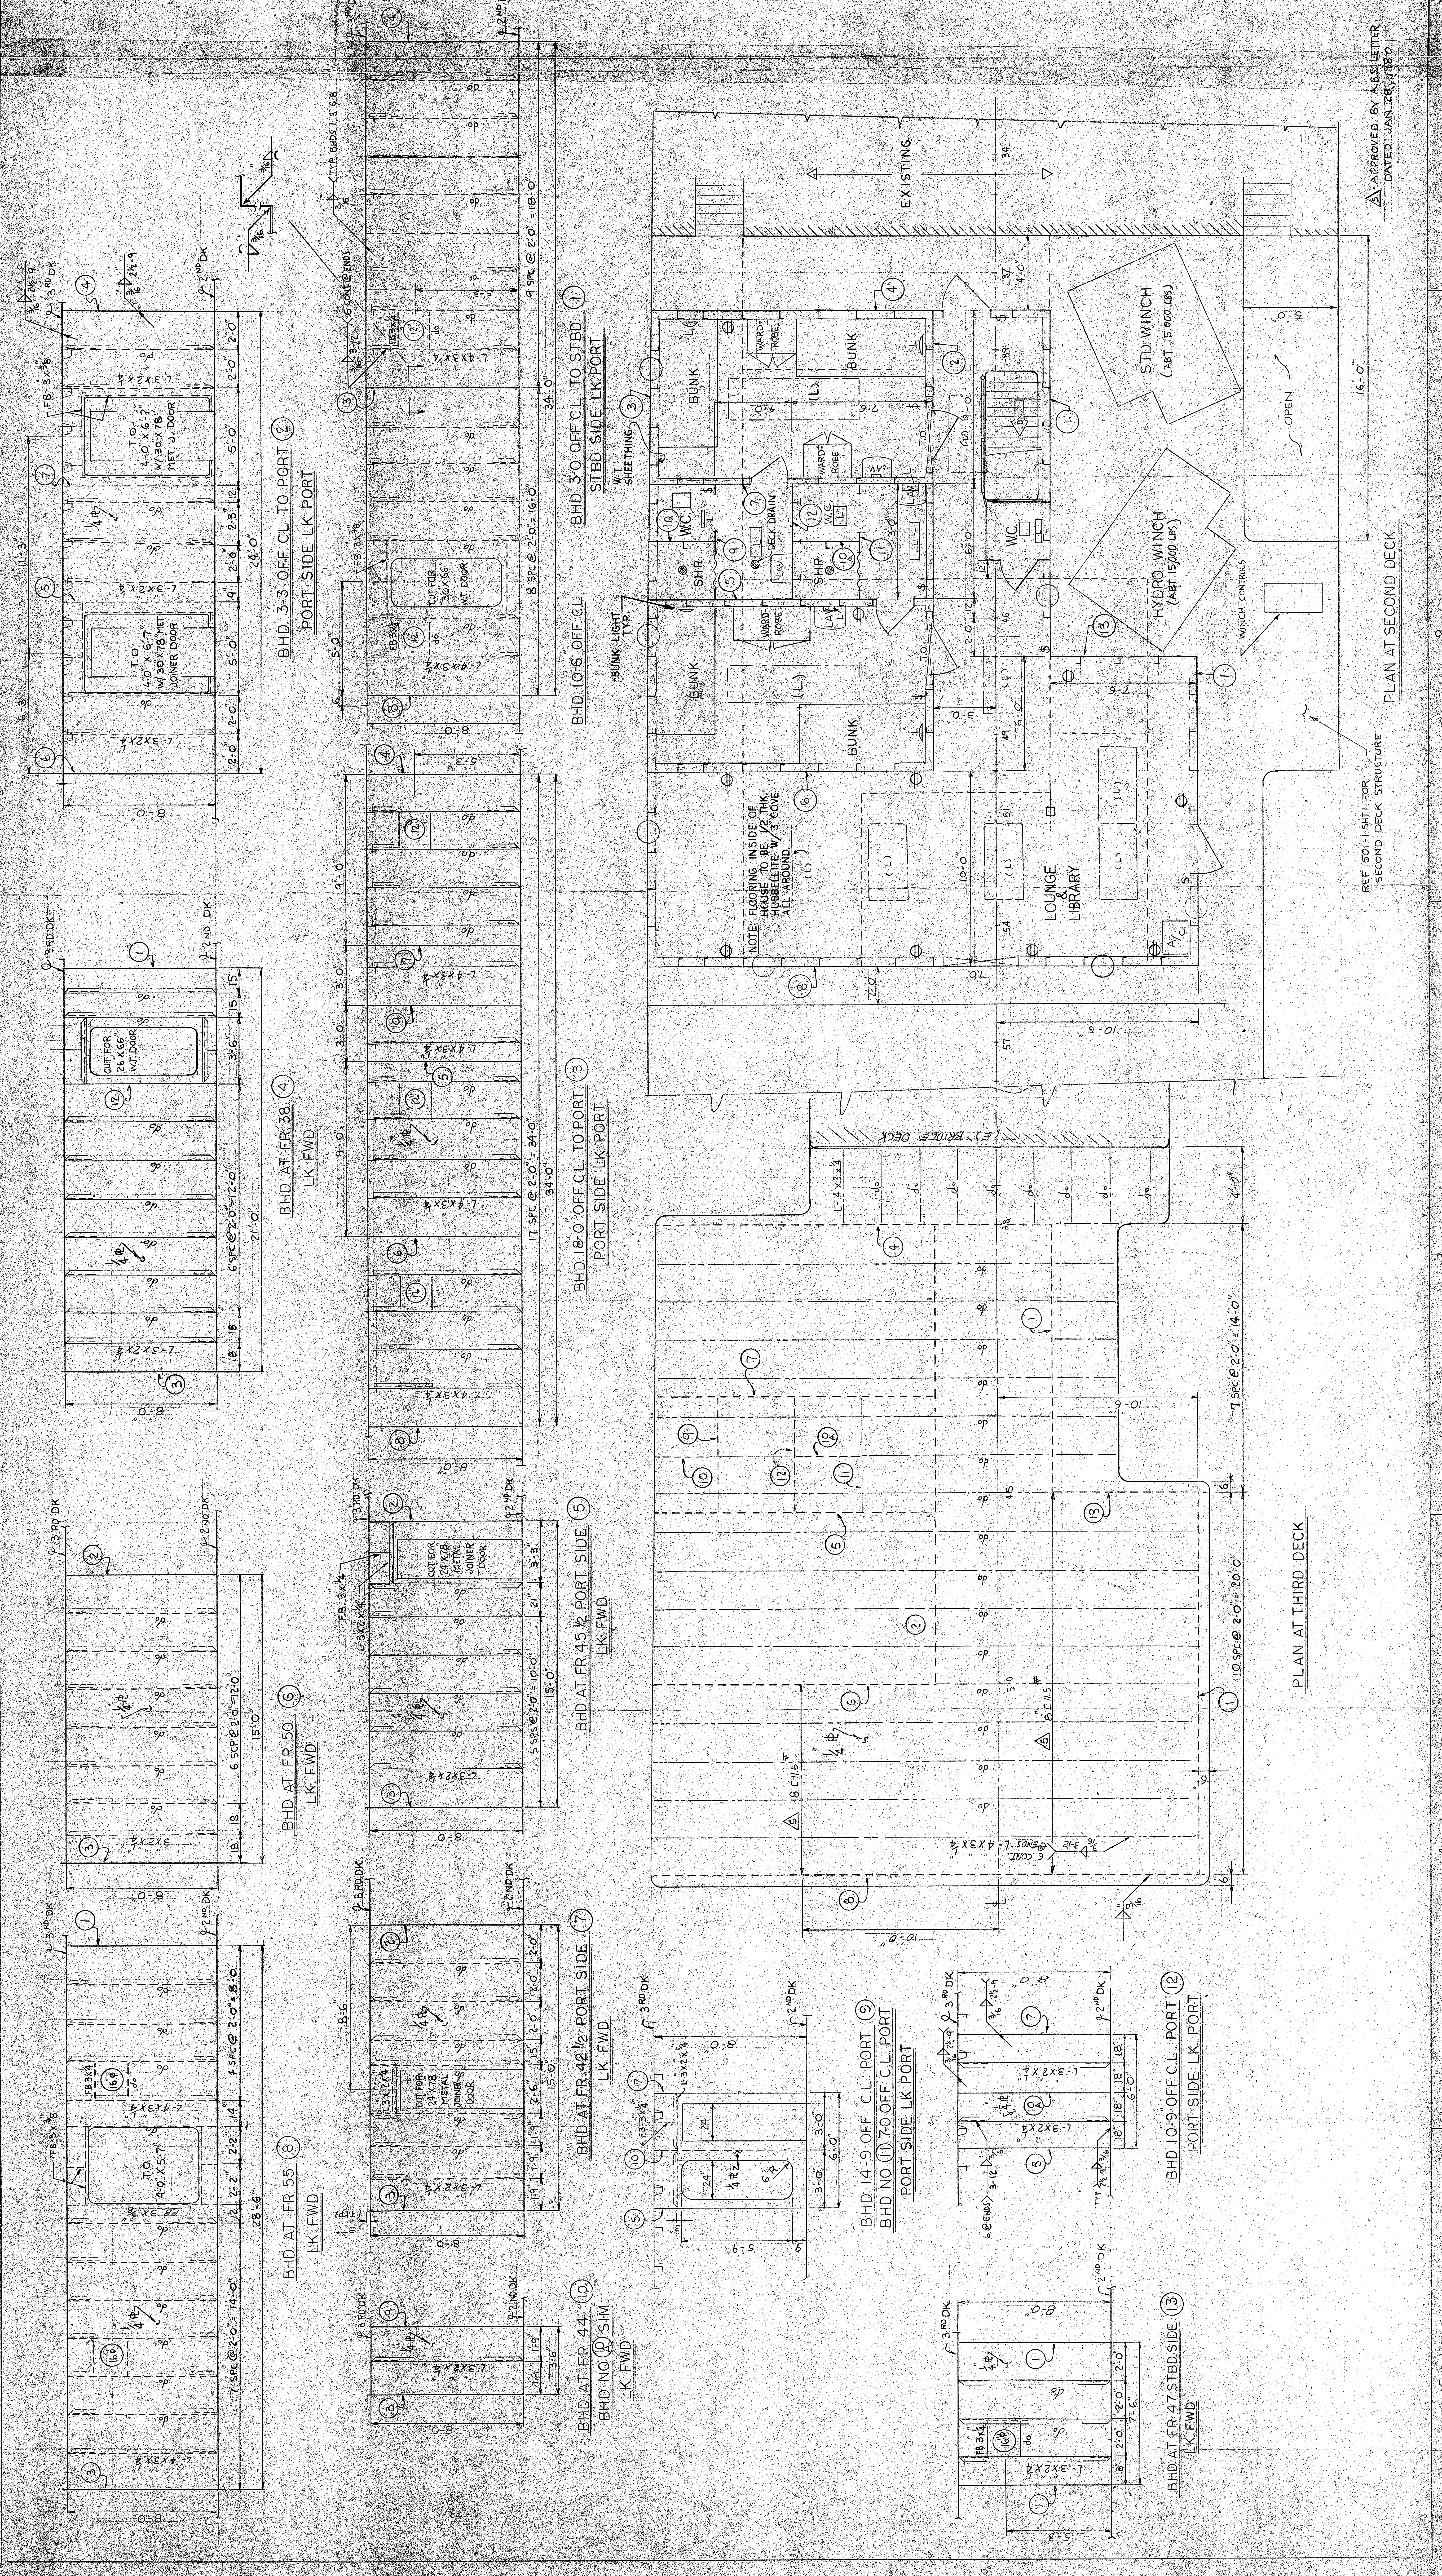

APPROVED BY A.S.S. LETTER
 DATED JAN 28, 1980

REF 1501-1 SHIT FOR
 SECOND DECK STRUCTURE

PLAN AT SECOND DECK

PLAN AT THIRD DECK

2

3

4

5